

STATE OF KANSAS
STATE CORPORATION COMMISSION


WELL PLUGGING RECORD

Give All Information Completely
Make Required Affidavit
Mail or Deliver Report to:
Conservation Division
State Corporation Commission
800 Bitting Building
Wichita, Kansas

OR
FORMATION PLUGGING RECORD

Strike out upper line
when reporting plug-
ging off formations.

NORTH

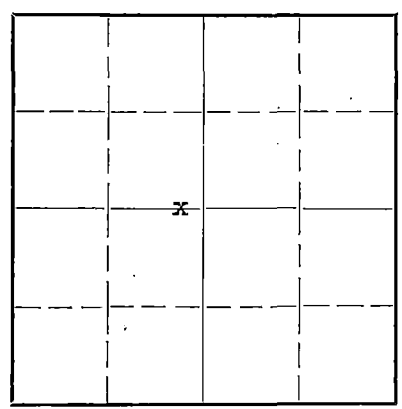

Locate well correctly on above
Section Plat

Haskell County. Sec. 6 Twp. 29S Rge. (E) 31 (W)
Location as "NE1/4NW1/4SW1/4" or footage from lines 50' West of Center of Sec. 6
Lease Owner The Carter Oil Company
Lease Name Harold Dietz Well No. 1
Office Address Box 786, Great Bend, Kansas
Character of Well (completed as Oil, Gas or Dry Hole) Dry Hole
Date well completed 9-2 19.45
Application for plugging filed 9-5 19.45
Application for plugging approved 9-10 19.45
Plugging commenced 10-18 19.45
Plugging completed 10-23 19.45
Reason for abandonment of well or producing formation Dry Hole

If a producing well is abandoned, date of last production 19
Was permission obtained from the Conservation Division or its agents before plugging was com-
menced? Yes

Name of Conservation Agent who supervised plugging of this well H. W. Kerr
Producing formation Depth to top Bottom Total Depth of Well 2922 Feet
Show depth and thickness of all water, oil and gas formations.

OIL, GAS OR WATER RECORDS


CASING RECORD

Formation	Content	From	To	Size	Put In	Pulled Out
				10 3/4"	588	0
				7"	2923	1349

Describe in detail the manner in which the well was plugged, indicating where the mud fluid was placed and the method or methods used in introducing it into the hold. If cement or other plugs were used, state the character of same and depth placed, from feet to feet for each plug set.

- Heavy Mud 2922' - 2680'
- Cement 2680' - 2655'
- Heavy Mud 2655' - 500'
- Rock bridge 500' - 490'
- Cement 490' - 480'
- Heavy Mud 480' - 20'
- Cement 20' - Base of cellar (6')
- Dirt 6' - Surface

FILE 6 24 31W
BOOK PAGE 25 LINE 17

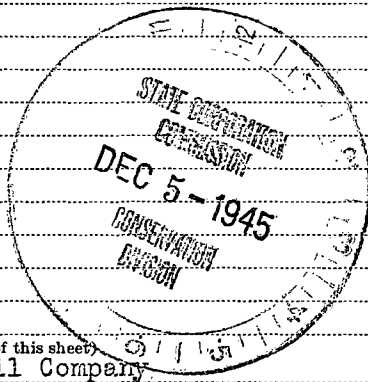

(If additional description is necessary, use BACK of this sheet)
Correspondence regarding this well should be addressed to The Carter Oil Company
Address Box 786, Great Bend, Kansas

STATE OF Kansas, COUNTY OF Barton, ss.
W. D. Maxwell (employee of owner) or (owner or operator) of the above-described well,
being first duly sworn on oath, says: That I have knowledge of the facts, statements, and matters herein contained and the log of the above-described well as filed and that the same are true and correct. So help me God.

(Signature) W. D. Maxwell District Supt.

(Address)

SUBSCRIBED AND SWORN to before me this 4 day of Dec, 19 45

My commission expires July 29, 1946
My commission expires Notary Public.