


STATE OF KANSAS
STATE CORPORATION COMMISSION

WELL PLUGGING RECORD

Give All Information Completely
Make Required Affidavit
Mail or Deliver Report to
Conservation Division
State Corporation Comm.
245 North Water
Wichita, KS 67202

Ford County. Sec. 26 Twp. 29S Rge. 25W E/W
Location as "NE/CNW $\frac{1}{4}$ SW $\frac{1}{4}$ " or footage from lines

C SE NE
Lease Owner Lee Banks (Banks Oil Company)
Lease Name Koppes Well No. 1
Office Address 200 W. Douglas, Suite 550, Wichita, KS 67202
Character of Well (Completed as Oil, Gas or Dry Hole)

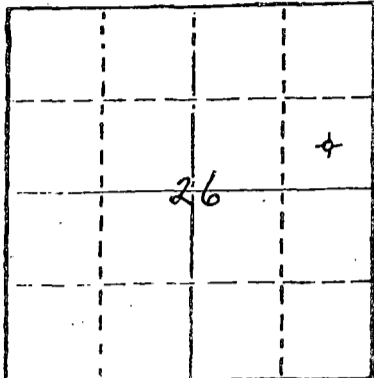

Locate well correctly on above
Section Plot

Dry Hole
Date Well completed September 14, 1981
Application for plugging filed September 14, 1981
Application for plugging approved September 14, 1981
Plugging commenced September 14, 1981
Plugging completed September 14, 1981
Reason for abandonment of well or producing formation

Dry Hole
If a producing well is abandoned, date of last production 19

Was permission obtained from the Conservation Division or
its agents before plugging was commenced? Yes

Name of Conservation Agent who supervised plugging of this well Paul Luthi
Producing formation Depth to top Bottom Total Depth of Well 5400'
Show depth and thickness of all water, oil and gas formations.

OIL, GAS OR WATER RECORDS

CASING RECORD

FORMATION	CONTENT	FROM	TO	SIZE	PUT IN	PULLED OUT
		0'	613'	8-5/8"	606.38'	None

Describe in detail the manner in which the well was plugged, indicating where the mud fluid was placed and the method or methods used in introducing it into the hold. If cement or other plugs were used, state the character of same and depth placed, from feet to feet for each plug set.

Plugged with rubber plug and 40 sacks cement
at 585'; 1 sack hulls and 10 sacks cement at 40';
and 10 sacks cement in rat hole.


(If additional description is necessary, use BACK of this sheet)

Name of Plugging Contractor Allied Cementing Co.

STATE OF KANSAS COUNTY OF SEDGWICK, ss.
John D. Knightley Agent (employee of owner) or (owner or operator)
of the above-described well, being first duly sworn on oath, says: That I have knowledge of
the facts, statements, and matters herein contained and the log of the above-described well
as filed and that the same are true and correct. So help me God.

(Signature) *[Signature]*
221 S. Broadway, Suite 400, Wichita, KS 67202
(Address)

SUBSCRIBED AND SWORN TO before me this 18th day of September, 19 81

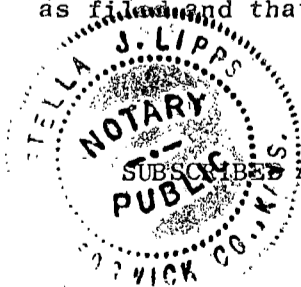

[Signature] Notary Public.

My commission expires March 12, 1983

RECEIVED
STATE CORPORATION COMMISSION

SEP 22 1981

CONSERVATION DIVISION
Wichita, Kansas

9-22-1981

Lee Banks - Koppes #1
 Banks Oil Company C SE NE Section 26-29S-25W
 200 W. Douglas, Suite 550 Ford County, Kansas
 Wichita, Kansas 67202

Contractor: D. R. Lauck Oil Company, Inc.
 221 S. Broadway, Suite 400
 Wichita, Kansas 67202

Commenced: September 3, 1981
 Completed: September 14, 1981

Drillers Log

Sand & Clay	435
Clay & Red Bed	616
Red Bed	930
Red Bed & Shale	1790
Shale & Shells	1930
Shale	2645
Shale & Lime	2840
Shale	3060
Shale & Lime	3425
Lime & Shale	3970
Shale & Lime	4130
Lime & Shale	4295
Lime	4800
Shale & Lime	4913
Lime	5400 RTD

RECEIVED
 STATE CORPORATION COMMISSION
 SEP 22 1981
 CONSERVATION DIVISION
 Wichita, Kansas