


STATE OF KANSAS
STATE CORPORATION COMMISSION
200 Colorado Derby Bldg.
Wichita, Kansas 67202

Form CP-4
Rev. 12-15-80

WELL PLUGGING RECORD

Give All Information Completely
Make Required Affidavit

COUNTY Ford SEC. 34 TWP. 29S RGE. 25W E/W
Location as in quarters or footage from lines:
NW/4 of NE/4 - 660' FNL & 1980' W of East Line

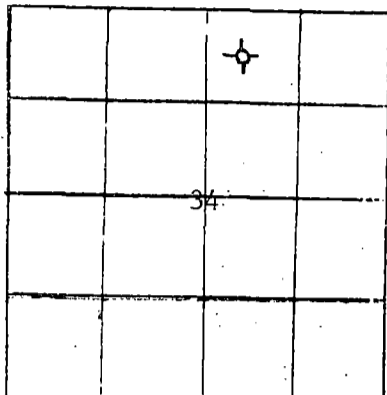

Lease Owner Arthur Ratzlaff
Lease Name Ratzlaff Well No. 1-34
Office Address 200 W. Douglas, Suite 550, Wichita, Kansas 67202
Character of Well (Completed as Oil, Gas or Dry Hole): Dry hole
Date Well Completed 6-8-82
Application for plugging filed 6-7-82
Plugging commenced 6-8-82
Plugging completed 6-8-82
Reason for abandonment of well or producing formation Dry hole-
no oil or gas.
Was permission obtained from the Conservation Division or it's
Agent's before plugging was commenced? Yes

Locate Well
correctly on above
Section Platt.

Name of Conservation Agent who supervised plugging of this well Paul Luthi

~~Producing~~ formation Morrow Sd. Depth to top 5259' bottom 5269' T.D. 5377'

Show depth and thickness of all water, oil and gas formations.

OIL, GAS OR WATER RECORDS

Casing Record

Formation	Content	From	To	Size	Put in	Pulled Out
Surf. pipe set by old operator-Leben	Drlg.			8 5/8"	379'	None
Perf. 5259-5269'-no production-all water				4 1/2"	5357'	2795'

Describe in detail the manner in which the well was plugged, indicating where the mud fluid was placed and the method or methods used in introducing it into the hold. If cement or other plugs were used, state the character of same and depth placed, from _____ feet to _____ feet for each plug set. Plugged hole with sand to 5200' in 4 1/2", dumped 4 sxs. cement on top with bailer, shot off 4 1/2" at 2795', pull pipe and plug hole with 50 sxs. at 425', 10 sxs. with cottonseed hulls from 40' to surface, plug hole with 10 sxs.

RECEIVED
STATE CORPORATION COMMISSION

JUN 15 1982

CONSERVATION DIVISION
Wichita, Kansas

6-15-1982

(If additional description is necessary, use BACK of this sheet)

Name of Plugging Contractor Pratt Well Service

STATE OF Kansas COUNTY OF Sedgwick, ss.

I, Lee Banks (employee of owner) or (owner or operator) of the above-described well, being first duly sworn on oath, says: That I have knowledge of the facts, statements, and matters herein contained and the log of the above-described well as filed and that the same are true and correct. So help me God.

(Signature) Lee Banks
200 W. Douglas, #550, Wichita, Ks.
(Address) 67202

SUBSCRIBED AND SWORN TO before me this 14th day of June, 1982

My Commission expires: 2-28-86

SHIRLEY WHITMORE
NOTARY PUBLIC
State of Kansas
My Appointment Expires:

Notary Public.

15-657-10008-0001

Phone 913-483-2627, Russell, Kansas
 Phone 316-793-5861, Great Bend, Kansas

Phone Plainville 913-434-2812
 Phone Kiowa 316-825-4618

ALLIED CEMENTING CO., INC.

No. 27769

Home Office P. O. Box 31

Russell, Kansas 67665

Old

Date	6-8-82	Sec.	34	Twp.	29	Range	25W	Called Out	1245 PM	On Location	2:30	Finish	3:30 PM
Lease	RAT-164A		Well No.	1-34		Location	Middleton 3N 16W 25E		County	Ford		State	KAN
Contractor	PRATT Well Service												
Type Job	Old Hole Plug												
Hole Size	7 1/2	T.D.											
Csg. Size	4 1/2	Depth											
Tbg. Size		Depth											
Drill Pipe		Depth											
Tool		Depth											
Cement Left in Csg.		Shoe Joint											
Press Max.		Minimum											
Meas Line		Displace											
Perf.													

Owner
 To Allied Cementing Co., Inc.
 You are hereby requested to rent cementing equipment and furnish cementer and helper to assist owner or contractor to do work as listed.

Charge To
 LEE BANKS

The above was done to satisfaction and supervision of owner agent or contractor.

Purchase Order No.
 X Lee Bank, Co.
CEMENT

Amount Ordered
 70sx com - 1sx hulls

Consisting of
 Common 70 4.75
 Poz. Mix
 Gel.
 Chloride
 Quickset
 Hulls 1sx 19.00

Sales Tax
 Handling 70 90
 Mileage 66

Sub Total
 Total

Floating Equipment

EQUIPMENT			
Pumptrk 67	No	Cementer	PRESTON
		Helper	DAVIS
Pumptrk	No	Cementer	
		Helper	
Bulktrk 150		Driver	RUSSELL
		Driver	

DEPTH of Job		
Reference:	PUMP TANK	360.00
	PLUG	10.00
	MILEAGE 1.00	
	Sub Total	
	Tax	
	Total	

Remarks:
 55sx - 3/20
 15sx - 40' - RUBBER PLUG

Thank You

RDs MUST
TYPED

STATE OF KANSAS
NOTICE OF INTENTION TO DRILL

MAY 19 1982

C-1
MI-1331

TO BE FILED WITH THE STATE CORPORATION COMMISSION
5 DAYS PRIOR TO COMMENCEMENT OF WELL THIS PERMIT

Permit Number 15- OWWO
(For office use only)

Operator Lee Banks NOV 17 1982

Starting Date 5 / 19 / 82
Month Day Year

Mailing Address 200 W. Douglas #550

EXPIRES

County Ford

Street Address 200 W. Douglas #550

Sec. 34 Twp. 29S S. Rng. 25W East West

City-State Wichita, KS Zip Code 67202

660 ft. from (N) (S) Line
Circle Correct Direction

Contact person LeeBanks Phone # 316 267 0783

660 ft. from (E) (W) Line

Contractor Unknown

Exact Spot Location C NW NE

Street Address _____

Nearest Lease Line 660'

City-State _____ Zip Code _____

Lease Name Ratzlaff

Type of Equipment: Rotary Air _____ Cable Tools _____

Well No. #1

Well to be Drilled for: Oil Gas SWD _____ Input _____

Est. Total Depth 5378 ft.

Well Classification: Infield _____ Pool Ext. _____ Wildcat

Depth of Deepest Fresh Water within 1 mile 200' ft.

Depth of Municipal Water Well within 3 miles 200' ft.

Depth to Protect all Fresh Water (Table 1) 250' ft.

Amount of Surface Casing to be set 379' previously _____ ft.

(Surface Casing) Alternate No. 1X Alternate No. 2

\$40.00 FEE PAID OWWO Leben Drilling OPERATOR STATES THAT HE WILL COMPLY WITH K.S.A. 55-128

REMARKS: 5-1782 #1 McConnell D&A 1-10-63 copy scout card attached
Signature of Operator Geo. ...

263 3238
copy Comm