


STATE OF KANSAS
STATE CORPORATION COMMISSION

WELL PLUGGING RECORD

Give All Information Completely
Make Required Affidavit
Mail or Deliver Report to
Conservation Division
State Corporation Comm.
245 North Water
Wichita, KS 67202

Ford County. Sec. 34 Twp. 29S Rge. 25W E/W
Location as "NE/CNW $\frac{1}{4}$ SW $\frac{1}{4}$ " or footage from lines
C N/2 NE NW

Lease Owner Banks Oil Company
Lease Name Wyatt Well No. 1
Office Address 200 W. Douglas, Suite 550, Wichita, Ks.
Character of Well (Completed as Oil, Gas or Dry Hole) Dry Hole

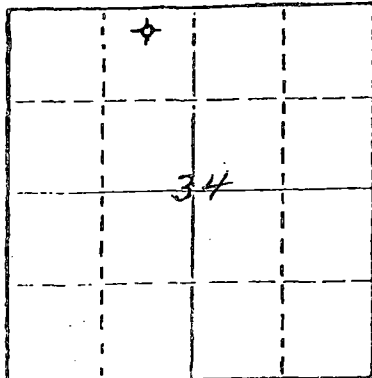

Locate well correctly on above
Section Plat

Date Well completed April 1, 1980
Application for plugging filed April 1, 1980
Application for plugging approved April 1, 1980
Plugging commenced April 1, 1980
Plugging completed April 1, 1980

Reason for abandonment of well or producing formation Dry Hole
If a producing well is abandoned, date of last production 19__

Was permission obtained from the Conservation Division or its agents before plugging was commenced? Yes

Name of Conservation Agent who supervised plugging of this well Clarence Thomas, Jr.
Producing formation _____ Depth to top _____ Bottom _____ Total Depth of Well 5330'
Show depth and thickness of all water, oil and gas formations.

OIL, GAS OR WATER RECORDS

CASING RECORD

FORMATION	CONTENT	FROM	TO	SIZE	PUT IN	PULLED OUT
		0'	456'	8-5/8"	449.75'	None

Describe in detail the manner in which the well was plugged, indicating where the mud fluid was placed and the method or methods used in introducing it into the hold. If cement or other plugs were used, state the character of same and depth placed, from _____ feet to _____ feet for each plug set.

Plugged with 60 sacks cement at 450',
10 sacks cement and bridge plug at 40',
and 5 sacks cement in rat hole.

RECEIVED
APR 18 1980
DIVISION

(If additional description is necessary, use BACK of this sheet)
Name of Plugging Contractor Allied Cementing Co.


STATE OF KANSAS COUNTY OF SEDGWICK, ss.
John D. Knightley Agent (employee of owner) or (owner or operator)
of the above-described well, being first duly sworn on oath, says: That I have knowledge of the facts, statements, and matters herein contained and the log of the above-described well as filed and that the same are true and correct. So help me God.

(Signature) [Signature]
221 S. Broadway, Wichita, Kansas 67202
(Address)

SUBSCRIBED AND SWORN TO before me this 17th day of April, 1980

[Signature]
Notary Public.

My commission expires March 12, 1983

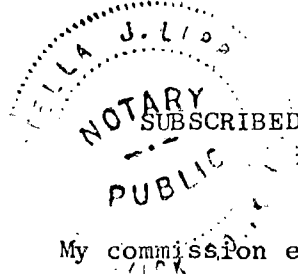

Banks Oil Company
200 W. Douglas, Suite 550
Wichita, Kansas 67202

- Wyatt #1
C N/2 NE NW Sec. 34-29S-25W
Ford County, Kansas

Contractor: D. R. Lauck Oil Company, Inc.
221 S. Broadway, Suite 400
Wichita, Kansas 67202

Commenced: March 20, 1980
Completed: April 1, 1980

Drillers Log

Clay & Sand	108
Gyp & Shale	710
Clay & Shale	950
Red Bed & Shale	1565
Shale	2220
Shale & Lime	2620
Lime & Shale	2845
Shale & Lime	3150
Shale	3200
Shale & Lime	4582
Lime & Shale	4678
Lime	4725
Lime & Shale	4795
Shale & Lime	4910
Lime	5000
Shale & Lime	5780
Lime	5330 RTD

RECEIVED
STATE CORPORATION COMMISSION

APR 18 1980

CONSERVATION DIVISION
Wichita, Kansas