


STATE OF KANSAS
STATE CORPORATION COMMISSION
CONSERVATION DIVISION
P. O. BOX 17027
WICHITA, KANSAS 67217

FORM CP-4

WELL PLUGGING RECORD

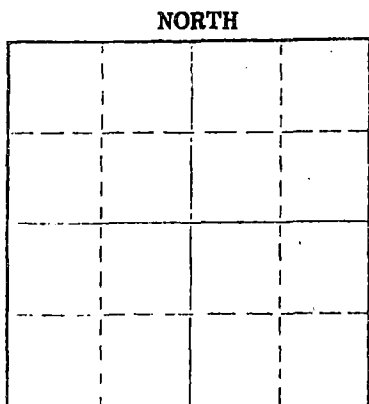

Locate well correctly on above Section Plat

Sedgwick County. Sec. 11 Twp. 27 Rge. 1W (E) (W)
Location as "NE/CNW&SW" or footage from lines. C N/2 NE NW
Lease Owner Drillers Production Company
Lease Name Slease #1 Well No. _____
Office Address Wichita, Kansas 67202
Character of Well (completed as Oil, Gas or Dry Hole) _____
Date well completed _____ 19____
Application for plugging filed _____ 19____
Application for plugging approved _____ 19____
Plugging commenced 9/18/75 19____
Plugging completed 9/23/75 19____
Reason for abandonment of well or producing formation depleted.
If a producing well is abandoned, date of last production _____ 19____
Was permission obtained from the Conservation Division or its agents before plugging was commenced? yes

Name of Conservation Agent who supervised plugging of this well Dewey
Producing formation _____ Depth to top _____ Bottom _____ Total Depth of Well 2733 Feet
Show depth and thickness of all water, oil and gas formations.

OIL, GAS OR WATER RECORDS

CASING RECORD

FORMATION	CONTENT	FROM	TO	SIZE	PUT IN	PULLED OUT
				10-3/4	175	none
				7"	2733	1958'

Describe in detail the manner in which the well was plugged, indicating where the mud fluid was placed and the method or methods used in introducing it into the hole. If cement or other plugs were used, state the character of same and depth placed, from _____ feet to _____ feet for each plug set.

Sanded to 2690' and ran 7 sacks cement. Checked hole, shot pipe at 2022', ~~198~~ 1968', pulled 63 joints. Bailed hole to 220', rock bridge to 200' and filled hole with 5 yards ready mix.

PLUGGING COMPLETE

RECEIVED
STATE CORPORATION COMMISSION

OCT 31 1975

CONSERVATION DIVISION
Wichita, Kansas

Name of Plugging Contractor KNIGHT CASING PULLING CO., INC.
Address CHASE, KANSAS


STATE OF KANSAS COUNTY OF RICE, ss. NOEL J. KNIGHT (employee of owner) or (owner or operator) of the above-described

well, being first duly sworn on oath, says: That I have knowledge of the facts, statements, and matters herein contained and the log of the above-described well as filed and that the same are true and correct. So help me God.

(Signature) Noel Knight
CHASE, KANSAS
(Address)

Subscribed and Sworn to before me this 29th day of September, 19 75

My commission expires _____

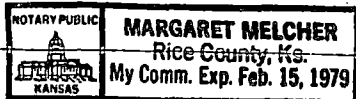

Margaret Melcher
Notary Public.

II
of
Director of
I
1977

of
1977

1977

of
1977




Drillers gas

SPRINGER & HARPER

BOX 101

CUNNINGHAM, KANSAS

December 22, 1947

The Drillers Gas Company, Wichita, Kansas.

Sease # 1

Sedgwick County, Kansas.

*Comp 12-10-47
at 15-65
Pot 170 BOPD*

Q 7 1/2 NE 1/4 NW 1/4 11-27-1 W.

sand	60
shale & shells	195
lime	451
shale	477
lime	520
lime & shale	570
lime	640
green shale	650
lime	665
shale	675
lime & shale	745
lime	835
lime & shale	980
lime	1000
lime & shale	1065
lime	1100
shale	1310
shale & lime	1545
lime	1595
lime & shale	1680
lime	1710
lime & shale	1795
lime	1935
sand	1975
sandy lime	2060
shale	2080
lime	2100
shale	2120
lime	2145
lime & shale	2165
shale	2310
lime	2340
shale & lime	2364
shale	2390
lime & shale	2527
shale	2589
lime	2736
T. D.	2736

Run 175 ft. of 10 3/4 " seamless 40# second hand surface pipe and cemented with 175 sacks of cement.

Run 2736 ft. of 22# 7" used casing and cemented with 150 sacks of cement.

Elevation 1376 KC 2586

Porosity and Odor 2706-2713

46 shots 2706 1/2 - 2713 1/2

Est 3 BOPD

1000 gal acid

Mat. Potential 170 BOPD.

CONSERVATION DIVISION
Wichita, Kansas

AUG 28 1947

RECEIVED
STATE CORPORATION COMMISSION

Springer & Harper

By *L. L. Harper*