


STATE OF KANSAS
STATE CORPORATION COMMISSION

WELL PLUGGING RECORD

Give All Information Completely
Make Required Affidavit
Mail or Deliver Report to:
Conservation Division
State Corporation Commission
800 Bitting Building
Wichita, Kansas

OR
FORMATION PLUGGING RECORD Strike out upper line when reporting plugging of formations.

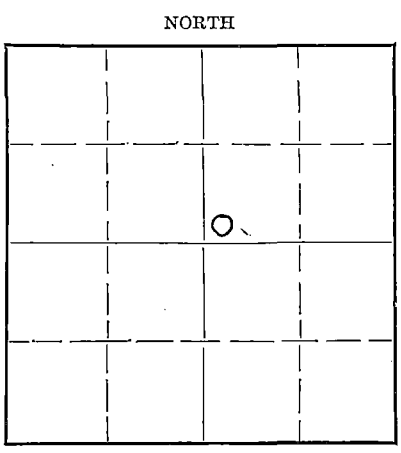

Sedgwick County. Sec. 29. Twp. 27. Rge. 4. (H) (W)
Location as "NE 1/4 NW 1/4 SW 1/4" or footage from lines SW SW NE
Lease Owner J. M. Huber Corp. & Pabco Drilling, Inc.
Lease Name Webb Well No. 1
Office Address 818 Central Bldg.
Character of Well (completed as Oil, Gas or Dry Hole) D & A
Date well completed March 7 1949
Application for plugging filed March 8 1949
Application for plugging approved March 8 1949
Plugging commenced March 8 1949
Plugging completed March 8 1949
Reason for abandonment of well or producing formation D & A

If a producing well is abandoned, date of last production --- 19
Was permission obtained from the Conservation Division or its agents before plugging was commenced? yes

Name of Conservation Agent who supervised plugging of this well J. P. Roberts
Producing formation Arbuckle Depth to top 4300 Bottom Total Depth of Well 4335 Feet
Show depth and thickness of all water, oil and gas formations.

OIL, GAS OR WATER RECORDS

CASING RECORD

Formation	Content	From	To	Size	Put In	Pulled Out
	No Shows					

Describe in detail the manner in which the well was plugged, indicating where the mud fluid was placed and the method or methods used in introducing it into the hole. If cement or other plugs were used, state the character of same and depth placed, from _____ feet to _____ feet for each plug set.

Filled Hole with Mud up to 210 foot, ran plug and 10 sacks of cement, filled to top of Hole with mud then cemented with 5 sacks of cement.

RECEIVED
Conservation Div.
MAR 17 1949
STATE CORPORATION
COMMISSION
KANSAS

3-17-49

(If additional description is necessary, use BACK of this sheet)

Correspondence regarding this well should be addressed to Pabco Drilling, Inc.
Address 818 Central Bldg

STATE OF Kansas, COUNTY OF Sedgwick, ss.
D. J. Briggs (employee of owner) or (owner or operator) of the above-described well,
being first duly sworn on oath, says: That I have knowledge of the facts, statements, and matters herein contained and the log of the above-described well as filed and that the same are true and correct. So help me God.

(Signature) Pabco Drilling Inc, By D. J. Briggs
818 Central Bldg, Wichita, Ka
(Address)

SUBSCRIBED AND SWORN TO before me this 15 day of March 1949
Ruth M Gardner
Notary Public.

My commission expires March 2, 1952

