


STATE OF KANSAS
STATE CORPORATION COMMISSION

WELL PLUGGING RECORD

Give All Information Completely
Make Required Affidavit
Mail or Deliver Report to:
Conservation Division
State Corporation Commission
800 Bittling Building
Wichita, Kansas

Sedgwick County, Sec. 2017 Twp. 27S Rge. 4 # (W)
SW SW SE

NORTH

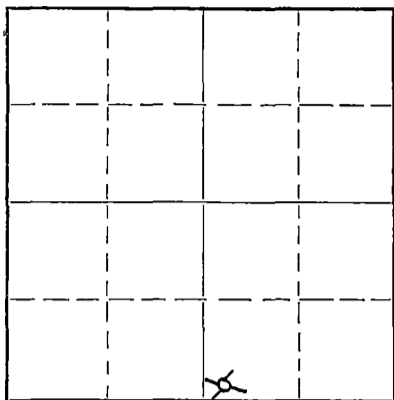

Locate well correctly on above
Section Plat

Location as "NE/CNW $\frac{1}{4}$ SW $\frac{1}{4}$ " or footage from lines
Lease Owner Mallard Drg. Co.
Lease Name Abercrombie Well No. 1
Office Address 1016 Union National Bank
Character of Well (completed as Oil, Gas or Dry Hole) Dry Hole
Date well completed August 11 19 50
Application for plugging filed " 19 "
Application for plugging approved " 19 "
Plugging commenced " 19 "
Plugging completed " 19 "
Reason for abandonment of well or producing formation
If a producing well is abandoned, date of last production 19
Was permission obtained from the Conservation Division or its agents before plugging was commenced? yes--oral

Name of Conservation Agent who supervised plugging of this well
Producing formation Depth to top Bottom Total Depth of Well 3710 Feet
Show depth and thickness of all water, oil and gas formations.

OIL, GAS OR WATER RECORDS

CASING RECORD

Formation	Content	From	To	Size	Put In	Pulled Out
				8 5/8"	205'	none

Describe in detail the manner in which the well was plugged, indicating where the mud fluid was placed and the method or methods used in introducing it into the hole. If cement or other plugs were used, state the character of same and depth placed, from feet to feet for each plug set.

Filled hole full heavy mud to 205' of top, drove wooden plug to 205' and dumped in 5 sacks cement. Finished filling hole with heavy mud to within 30' of cellar and put in 5 sacks cement.

(If additional description is necessary, use BACK of this sheet)

Correspondence regarding this well should be addressed to Mallard Drilling Company
Address 1016 Union National Bank

STATE OF Kansas, COUNTY OF Sedgwick
C. C. Nelson, partner (Employee or owner) or (owner or operator) of the above-described well,
being first duly sworn on oath, says: That I have knowledge of the facts, statements, and matters herein contained and the log of the above-described well as filed and that the same are true and correct. So help me God.

(Signature) C. C. Nelson

SUBSCRIBED AND SWORN to before me this 21st day of August 19 50

(Address) Wichita, Kansas
Raymond Wright Notary Public.

My commission expires 12/4/52

PLUGGING
FILE SEC 17T27R4W
BOOK PAGE 21 LINE 10

AUG 22 1950
8-22-50

COMPANY: Mallard Drilling Company
 CONTRACTOR: Mallard Drilling Company
 FARM: Abercrombie #1
 LOCATION: SW SW SE Sec. ~~20~~²²-278-4W
 Sedgwick County, Kansas
 COMMENCED: July 29, 1950
 COMPLETED: August 11, 1950

0	to	205	Surface sand
205	to	1075	Shale and lime
1075	to	1280	Shale and lime
1280	to	1870	Shale and lime
1870	to	2350	Lime and shale
2350	to	2680	Lime and shale
2680	to	2885	Shale and lime
2885	to	3030	Lime
3030	to	3210	Lime
3210	to	3280	Lime
3280	to	3470	Lime and shale
3470	to	3545	Lime and shale
3545	to	3622	Lime and shale
3622	to	3675	Lime and chert
3675	to	3697	Cherty lime
3697	to	3710	Lime and chert
		3710	T.D.

Set 205 feet of 8 5/8" surface pipe. Cemented with 150 sacks cement.

TOPS: Lansing 2818 Brown Line 2878

T.D. 3710

DRY, ABANDONED AND PLUGGED

Measurements taken from derrick floor.

C E R T I F I C A T E


I, G. C. Nelson, do hereby certify that the above and foregoing is a true and correct copy of log of the Abercrombie #1, SW SW SE, Sec. 20-278-4W, Sedgwick County, Kansas, as reflected by files of the Mallard Drg. Company.

G. C. Nelson

Subscribed and sworn to before me a Notary Public, within and for Sedgwick County, Kansas, this 15th day of August 1950.

Harwell Wright

My commission expires 12/4/52

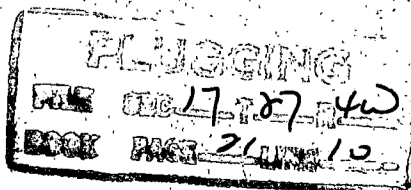

AUG 10 1950

NOTARY PUBLIC