

STATE OF KANSAS
STATE CORPORATION COMMISSION

WELL PLUGGING RECORD

Give All Information Completely
Make Required Affidavit
Mail or Deliver Report to:
Conservation Division
State Corporation Commission
211 No. Broadway
Wichita, Kansas

Sedgwick County, Sec. 5 Twp 27S Rge. 4 (NE) (W)

Location as "NE/CNW/SW" or footage from lines 330' FSL & 330' FWL of SE/4

Lease Owner Kewanee Oil Company

Lease Name Lampe Well No. 1

Office Address Box 589, El Dorado, Kansas

Character of Well (completed as Oil, Gas or Dry Hole) Dry Hole

Date well completed 3-5-61 19 61

Application for plugging filed 3-5-61 19 61

Application for plugging approved 3-4-61 19 61


Plugging commenced 3-5-61 19 61

Plugging completed 3-5-61 19 61

Reason for abandonment of well or producing formation Dry

If a producing well is abandoned, date of last production ----- 19 ---

Was permission obtained from the Conservation Division or its agents before plugging was commenced? Yes

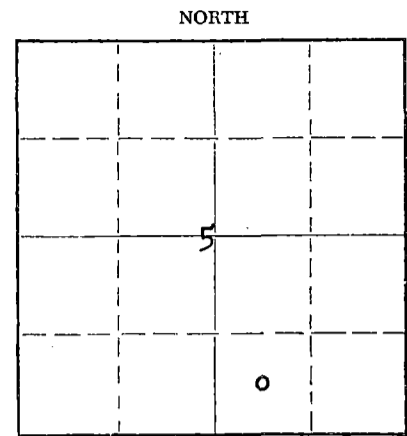

Locate well correctly on above Section Plat

Name of Conservation Agent who supervised plugging of this well Lee Guthrie

Producing formation None Depth to top _____ Bottom _____ Total Depth of Well 4193 Feet

Show depth and thickness of all water, oil and gas formations.

OIL, GAS OR WATER RECORDS

CASING RECORD

| FORMATION | CONTENT | FROM | TO | SIZE | PUT IN | PULLED OUT |
|-----------|---------|------|----|-------|--------|------------|
| | | | | 8-5/8 | 258 | None |
| | | | | | | |
| | | | | | | |
Describe in detail the manner in which the well was plugged, indicating where the mud fluid was placed and the method or methods used in introducing it into the hole. If cement or other plugs were used, state the character of same and depth placed, from _____ feet to _____ feet for each plug set.

Filled hole to 240' with heavy rotary mud and spotted 1/2 sack hulls and 15 sacks reg. cement. Filled hole to 35' and spotted 10 sks. reg. cement on top of 1/2 sk. hulls. Filled to surface.

RECEIVED
STATE CORPORATION COMMISSION
MAR 15 1961
CONSERVATION DIVISION
Wichita, Kansas

3-15-61

(If additional description is necessary, use BACK of this sheet)

Name of Plugging Contractor Gross Drilling Company

Address Box 510, El Dorado, Kansas

STATE OF Kansas, COUNTY OF Butler, ss. E. J. Veazey

(employee of owner) or (owner or operator) of the above-described well, being first duly sworn on oath, says: That I have knowledge of the facts, statements, and matters herein contained and the log of the above-described well as filed and that the same are true and correct. So help me God.

(Signature) E. J. Veazey
Box 589, El Dorado, Kansas
(Address)

SUBSCRIBED AND SWORN TO before me this 10 day of March, 19 61

My commission expires 11-28-64

[Signature]
Notary Public.

KEWANEE OIL COMPANY

El Dorado District

WELL RECORD & SANDOLOGY: Lampe # 1

LOCATION: 330' FSL and 330' FWL of SE/4 Sec. 5, T-27-S,
R-4-W, Sedgwick County, Kansas.

ELEVATION: 1390' C.M.

DRILLING COMMENCED: 2-15-61 Gross Drilling Co. - Rotary Tools

DRILLING COMPLETED: 3-5-61

COMPLETION DATE: 3-5-61 Plugged and Abandoned

TOTAL DEPTH: 4193' C.M.

INITIAL PRODUCTION: None - P&A

FORMATION TOPS (Schlumberger)

| | | |
|---------------|-------|-------|
| Lensing K.C. | 2810' | -1420 |
| Mississippian | 3635' | -2245 |
| Viola | 4038' | -2648 |
| Simpson | 4056' | -2666 |
| Arbuckle | 4162' | -2772 |

CASING RECORD

Ran 12 jts. (258.16') of 8-5/8", 32#, 8V, R-1, TC, Reg., "B" condition casing and set at 261.16' C.M. Cemented by HOWCO with 225 sks. reg. admix 2% calcium chloride, Cement circulated.

FORMATION RECORD

| | | | |
|------|---|------|--------------------------------------|
| 0 | - | 340 | Sand and shaley sand |
| 340 | - | 610 | Lime w/sand and shale streaks |
| 610 | - | 831 | Shale w/lime streaks |
| 831 | - | 1166 | Shale and shaley sand w/lime streaks |
| 1166 | - | 1606 | Lime w/sand and shale streaks |
| 1606 | - | 1862 | Shale and shaley sand |
| 1862 | - | 1987 | Lime w/sand and shale |
| 1987 | - | 2050 | Shale |
| 2050 | - | 2141 | Sand w/shale and lime streaks |
| 2141 | - | 2196 | Shale |
| 2196 | - | 2502 | Sand w/shale and lime streaks |
| 2502 | - | 2622 | Lime w/shale streaks |
| 2622 | - | 2647 | Sand |
| 2647 | - | 2810 | Shale |
| 2810 | - | 3635 | Lensing K-C Lime |
| 3635 | - | 3913 | Mississippian Lime |
| 3913 | - | 4038 | Shale w/lime streaks |
| 4038 | - | 4056 | Viola Lime |
| 4056 | - | 4162 | Simpson Series w/shale streaks |
| 4162 | - | 4193 | Arbuckle Lime |
| | | 4193 | T.D. |

RECEIVED
STATE CORPORATION COMMISSION
MAR 15 1961
CONSERVATION DIVISION
Wichita, Kansas