

Wells

15-097-26297-0000


STATE OF KANSAS
STATE CORPORATION COMMISSION

WELL PLUGGING RECORD

Give All Information Completely
Make Required Affidavit
Mail or Deliver Report to
Conservation Division
State Corporation Comm.
245 North Water
Wichita, KS 67202

Kiowa County. Sec. 16 Twp. 28S Rge. 16W E/W
Location as "NE/CNW 1/4 SW 1/4" or footage from lines
2010 FNL, 1630 FEL

Lease Owner Texas Oil and Gas Company
Lease Name Kinney Well No. 1
Office Address 200 W. Douglas, Suite 300, Wichita, Kansas
Character of Well (Completed as Oil, Gas or Dry Hole) _____

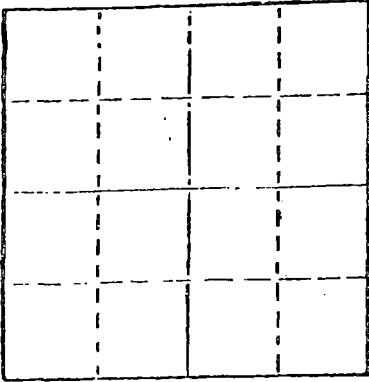

Locate well correctly on above
Section Plat

Gas
Date Well completed _____ 19____
Application for plugging filed _____ 4-5- _____ 1979
Application for plugging approved _____ 4-7 _____ 1979
Plugging commenced _____ 7-3 _____ 1979
Plugging completed _____ 7-13 _____ 1979
Reason for abandonment of well or producing formation _____

Dry
If a producing well is abandoned, date of last production _____ 19____

Was permission obtained from the Conservation Division or its agents before plugging was commenced? Yes

Name of Conservation Agent who supervised plugging of this well Bill Owens
Producing formation _____ Depth to top _____ Bottom _____ Total Depth of Well _____
Show depth and thickness of all water, oil and gas formations.

OIL, GAS OR WATER RECORDS

CASING RECORD

FORMATION	CONTENT	FROM	TO	SIZE	PUT IN	PULLED OUT
				8 5/8	461	None
				4 1/2	4829	2850

Describe in detail the manner in which the well was plugged, indicating where the mud fluid was placed and the method or methods used in introducing it into the hold. If cement or other plugs were used, state the character of same and depth placed, from _____ feet to _____ feet for each plug set.

Sand From 4765 to 4665
4 sacks cement From 4665 to 4625

Built wood bridge at 420
Rock to 410
7 yards of Ready Mix

RECEIVED
STATE CORPORATION COMMISSION
AUG - 8 1979
CONSERVATION DIVISION
Wichita, Kansas
8-8-1979

(If additional description is necessary, use BACK of this sheet)

Name of Plugging Contractor Clarke Corporation

STATE OF Kansas COUNTY OF Barber, ss.
Elmo R. Morgenstern (employee of ~~owner~~) or (owner or operator)
of the above-described well, being first duly sworn on oath, says: That I have knowledge of the facts, statements, and matters herein contained and the log of the above-described well as filed and that the same are true and correct. So help me God.

(Signature) *Elmo R. Morgenstern*
Medicine Lodge, Kansas 67104
(Address)

SUBSCRIBED AND SWORN TO before me this 20th day of July, 1979
Jessie Hamilton
Notary Public.

My commission expires April 4, 1982

DRILLERS' LOG'

15-097-26297-0000

TEXAS OIL & GAS CORPORATION
Kinney No. 1
2010' FNL & 1630' FEL of
Section 16-28S-16W
Kiowa County, Kansas

Commenced: 5-27-75
Completed: 6-6-75

Elevation: 2154 K.B.

Surface Casing: 455' of
8-5/8" cemented w/400 sx
common cement, 2% Cel,
3% cc. 5-27-75

<u>FORMATION</u>	<u>DEPTH</u>
Surface Hole	0 - 461
Lime Streaks	461 - 575
Red Beds	575 - 1064
Anhydrite	1064 - 1086
Red Beds & Shale	1086 - 1140
Shale	1140 - 2100
Shale & Lime Streaks	2100 - 2300
Lime & Shale	2300 - 3585
Lime	3585 - 3800
Lime & Shale	3800 - 3964
Lime	3964 - 4830 RTD

I do hereby certify that the foregoing statements are true and correct to the best of my knowledge and belief.

D N B DRILLING, INC.

James L. Donelson
JAMES L. DONELSON

STATE OF KANSAS: ss:

Subscribed and sworn to before me this 12th day of June, 1975.

My Commission Expires:
August 25, 1976

Ella Priess

Ella Priess, Notary Public

RECEIVED
STATE CORPORATION COMMISSION

JUN - 7 1979

CONSERVATION DIVISION
Wichita, Kansas


<i>Ella Priess</i>	
STATE NOTARY PUBLIC	
Sedgwick County, Kansas	
My Com. Expires Aug. 25, 1976	

WELL : KINNEY # 1

LOCATION : 2010' FHL + 1630' FEL SEC. 16-28S-16W KLAWA Co., KS

ELEVATION : 2149' G.L. 2154' K.B.

15-097-20297-0000

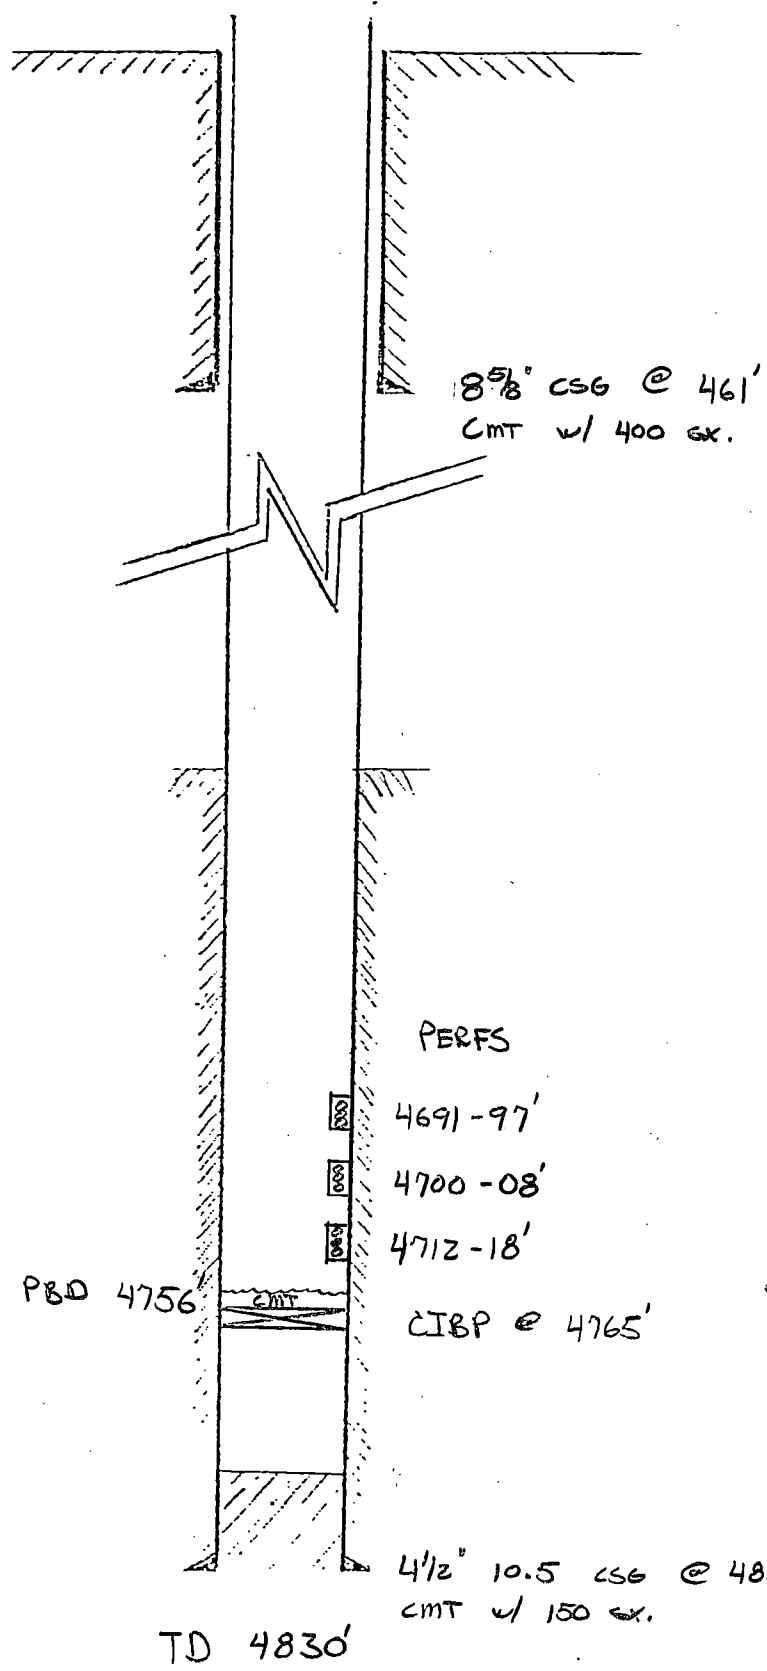

RECEIVED
STATE CORPORATION COMMISSION
JUN - 7 1979
CONSERVATION DIVISION
Wichita, Kansas