

WELL PLUGGING RECORD

See All Information Completely
Required Affidavit
or Deliver Report to:
Conservation Division
State Corporation Commission
211 No. Broadway
Wichita, Kansas

Kiowa County, Sec. 4 Twp. 28S Rge. 16W (X) (W)

Location as "NE/CNW/SW" or footage from lines C NW NE

Lease Owner Phillips Petroleum Company

Lease Name Davis K Well No. 1

Office Address Box 287, Great Bend, Kansas

Character of Well (completed as Oil, Gas or Dry Hole) Dry Hole

Date well completed 9-4-18-63 19

Application for plugging filed 9-4-18-63 19

Application for plugging approved 9-4-18-63 19


Plugging commenced 9-4-18-63 19

Plugging completed 9-4-18-63 19

Reason for abandonment of well or producing formation Dry Hole

If a producing well is abandoned, date of last production _____ 19

Was permission obtained from the Conservation Division or its agents before plugging was commenced? yes

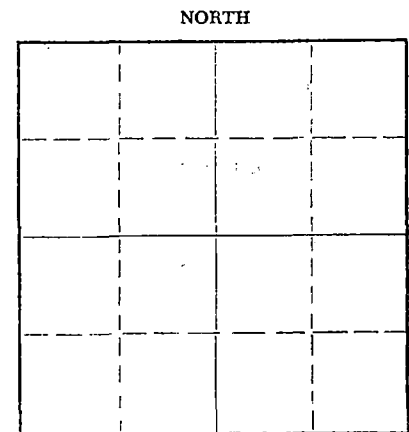

Locate well correctly on above
Section Plat

Name of Conservation Agent who supervised plugging of this well Archie Elving, Pratt, Kansas

Producing formation _____ Depth to top _____ Bottom _____ Total Depth of Well 4690 Feet

Show depth and thickness of all water, oil and gas formations.

OIL, GAS OR WATER RECORDS

CASING RECORD

FORMATION	CONTENT	FROM	TO	SIZE	PUT IN	PULLED OUT
				8 5/8"	386'	

Describe in detail the manner in which the well was plugged, indicating where the mud fluid was placed and the method or methods used in introducing it into the hole. If cement or other plugs were used, state the character of same and depth placed, from _____ feet to _____ feet for each plug set.

Mud to 240' with 1/2 sk. hulls and 25 sacks cement

Mud to 40' with 1/4 sk. hulls and 10 sacks cement
5 sacks in rat hole.

RECEIVED
STATE CORPORATION COMMISSION

SEP 20 1963

CONSERVATION DIVISION
Wichita, Kansas

9-20-1963

(If additional description is necessary, use BACK of this sheet)

Name of Plugging Contractor Leben Drilling, Inc.

Address P. O. Box 486, Great Bend, Kansas

STATE OF KANSAS, COUNTY OF BARTON, ss.

Leslie Kite (employee of owner) or (owner or operator) of the above-described

well, being first duly sworn on oath, says: That I have knowledge of the facts, statements, and matters herein contained and the log of the above-described well as filed and that the same are true and correct. So help me God.

(Signature) Leslie Kite

P. O. Box 486, Great Bend, Kansas

(Address)

SUBSCRIBED AND SWORN to before me this 18th day of September, 1963

Ulanda Nichols

Ulanda Nichols Notary Public.

My commission expires April 1, 1967

DRILLER'S LOG

COMPANY: Phillips Petroleum Company
 CONTRACTOR: LEBEN DRILLING, INC.
 FARM: DAVIS K-#1
 LOCATION: C NW NE Sec. 4-28S-16W
 KIOWA COUNTY, KANSAS
 COMMENCED: 9-5-63
 COMPLETED: 9-18-63

0	60	Top Soil & Sand
60	280	Sand
280	389	Surface Clay & Shale
389	750	Surface Clay & Redbed, Shale
750	2324	Shale
2324	2587	Lime & Shale
2587	2755	Shale & Lime
2755	3075	Lime & Shale
3075	3535	Shale & Lime
3535	4206	Lime & Shale
4206	4330	Lime
4330	4390	Lime & Shale
4390	4590	Lime
4590	4632	Lime & Shale
4632	4690	Lime
	<u>4690</u>	<u>Rotary Total Depth - D. & A.</u>

RECEIVED
 STATE CORPORATION COMMISSION

SEP 20 1963

CONSERVATION DIVISION
 Wichita, Kansas

Set 8 5/8" new Surface Casing @ 386' with landing joint Cemented with 110 sacks Common, 20% Diacel D and 300# c.c. followed with 50 sacks Common with 100# c.c.

I, Leslie Kite, do hereby certify that the above and foregoing is a true and correct copy of the log of the Davis K-#1 located, C NW NE of Section 4, Township 28 South, Range 16 West, Kiowa County, Kansas, as reflected by the files of Leben Drilling, Inc.

Leslie Kite
 Leslie Kite

STATE OF KANSAS)
) SS
 COUNTY OF BARTON)

Subscribed and sworn to before me, a Notary Public, in and for Barton County, Kansas, this 18th day of September, 1963.

Ulanda Nichols
 Ulanda Nichols, Notary Public

My Commission Expires:
 April 1, 1967