

Give All Information Completely
Make Required Affidavit
Map or Deliver Report to:
Conservation Division
State Corporation Commission
211 No. Broadway
Wichita, Kansas

WELL PLUGGING RECORD

Kiowa County, Sec. 25 Twp. 28 Rge. 18 (E) W (W)

Location as "NE/CNW/SW" or footage from lines C SE NW

Lease Owner Mull Drilling Co., Inc.

Lease Name William Keller Well No. 1

Office Address 670 N. 11th, Natl. Bank Bldg. Wichita, Kansas

Character of Well (completed as Oil, Gas or Dry Hole) Dry Hole

Date well completed 12-31- 1960

Application for plugging filed 12-31 1960

Application for plugging approved 12-31 1960

Plugging commenced 12:00 P.M. 12-31 1960

Plugging completed 1:00 P.M. 12-31 1960


Reason for abandonment of well or producing formation _____

Non Productive.

If a producing well is abandoned, date of last production None 19____

Was permission obtained from the Conservation Division or its agents before plugging was commenced? Yes

NORTH

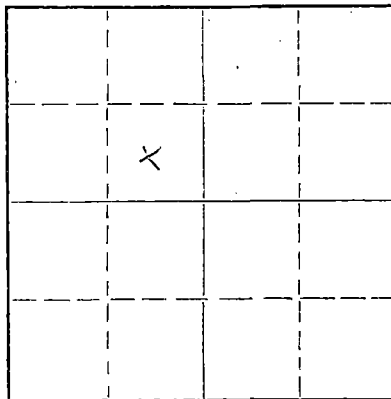

Locate well correctly on above Section Plat

Name of Conservation Agent who supervised plugging of this well Frank Broadfoot

Producing formation _____ Depth to top _____ Bottom _____ Total Depth of Well 4882' Feet

Show depth and thickness of all water, oil and gas formations.

OIL, GAS OR WATER RECORDS

CASING RECORD

FORMATION	CONTENT	FROM	TO	SIZE	PUT IN	PULLED OUT

Describe in detail the manner in which the well was plugged, indicating where the mud fluid was placed and the method or methods used in introducing it into the hole. If cement or other plugs were used, state the character of same and depth placed, from _____ feet to _____ feet for each plug set.

Hole filled with drilling mud to within 300' ft. of top of surface. Plug was pushed to this depth with $\frac{1}{2}$ sack hulls put on top of plug, and 20 sacks cement put in on top of plug through drill pipe. Hole then filled to within 35' of surface, $\frac{1}{2}$ sack hulls and a plug put at this depth with 10 sacks cement put on top of plug, this completed plugging. Two sacks cement put in rat hole bridging same.

Conservation Division
Wichita, Kansas

1-11-61

(If additional description is necessary, use BACK of this sheet)

Name of Plugging Contractor Drilling contractor tools.

Address Great Bend, Kansas

STATE OF KANSAS, COUNTY OF SEDGWICK, ss.

Joseph O. Butts (employee of owner) or (owner or operator) of the above-described well, being first duly sworn on oath, says: That I have knowledge of the facts, statements, and matters herein contained and the log of the above-described well as filed and that the same are true and correct. So help me God.

(Signature) Joseph O. Butts
Mull Drilling Co. - Wichita, Kansas
(Address)

SUBSCRIBED AND SWORN TO before me this 9th day of January, 1961

Ethel Zimmerman
Ethel Zimmerman
Notary Public.

My commission expires January 28, 1961



WELL LOG

15-097-00081-0000

COMPANY MULL DRILLING COMPANY

SEC. 25 T. 28S R. 18W

FARM KELLER NO. 1


LOC. C-SE, NW

TOTAL DEPTH 4878'

COUNTY KIOWA CO., KANSAS

COMM. December 16, 1960 COMP. December 31, 1960

CONTRACTOR GARVEY DRILLING COMPANY

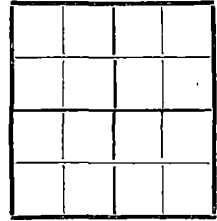

CASING 8 5/8" @ 439' w/250 sax.

ELEVATION 2219' DF

PRODUCTION D & A

FIGURES INDICATE BOTTOM OF FORMATIONS

90	Surface clay & shale
130	Sand
439	Shale
507	Sand
1250	Red bed
1990	Shale
2475	Shale & lime
3150	Lime & shale
3400	Shale & lime
3479	Shale
3570	Shale & lime
3890	Lime & shale
3960	Chalky lime & shale
4090	Lime
4166	Shale
4245	Lime & shale
4467	Lime
4537	Lime & shale
4627;	Lime
4740	Lime & shale
4840	Lime
4868	Chert
4878	Lime
4878	T. D.

RECEIVED
 STATE OF KANSAS
 JAN 23 1961
 CONSERVATION
 WICHITA

State of KANSAS }
 County of BARTON } ss.

I, VERNE A. MORRIS of GARVEY DRILLING COMPANY

upon oath state that the above and foregoing is a true and correct copy of the log of the #1 KELLER well

Verne A. Morris

Subscribed and sworn to before me this 19th day of January 19 61

My Commission Expires: November 12, 1962

[Signature]
 NOTARY PUBLIC