


WELL PLUGGING RECORD

Give All Information Completely
Make Required Affidavit
Mail or Deliver Report to:
Conservation Division
State Corporation Commission
211 No. Broadway
Wichita, Kansas

Kiowa County. Sec. 29 Twp. 28S Rge. ~~18~~ 18 (W)
Location as "NE/CNW/SW" or footage from lines 10' S. of Center NW SE
Lease Owner Gulf Oil Corporation
Lease Name Otto Weide Well No. 1
Office Address Box 661, Tulsa, Oklahoma
Character of Well (completed as Oil, Gas or Dry Hole) Dry hole
Date well completed 12-15 19 57
Application for plugging filed 12-15 19 57
Application for plugging approved Verbally 12-15-57 Letter 12-17-57
Plugging commenced 12-15 19 57
Plugging completed 12-15 19 57
Reason for abandonment of well or producing formation Dry hole

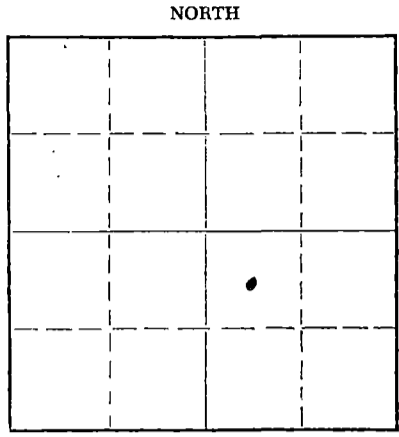

Locate well correctly on above Section Plat

If a producing well is abandoned, date of last production - - - 19 - -
Was permission obtained from the Conservation Division or its agents before plugging was commenced? Yes

Name of Conservation Agent who supervised plugging of this well J. Lewis Brock
Producing formation _____ Depth to top _____ Bottom _____ Total Depth of Well 5010 Feet
Show depth and thickness of all water, oil and gas formations.

OIL, GAS OR WATER RECORDS				CASING RECORD		
FORMATION	CONTENT	FROM	TO	SIZE	PUT IN	PULLED OUT
				8-5/8"	582'	0

Describe in detail the manner in which the well was plugged, indicating where the mud fluid was placed and the method or methods used in introducing it into the hole. If cement or other plugs were used, state the character of same and depth placed, from _____ feet to _____ feet for each plug set.
Filled hole with mud to 350'. Spotted HOWCO plug and 1/2 sack hulls. Spotted 35 sx. cement to 245'. Filled hole with mud to 35'. Placed HOWCO plug and capped with 15 sx. cement, filling hole into cellar.

Attached is Drillers Formation Record which was not available at time application was made.

NOTE: W. C. Bunch - Special Petty Cash, Check No. 1960, dated 12-23-57 in the amount of \$50.10, is attached as payment of plugging assessment.

RECEIVED
STATE CORPORATION COMMISSION
DEC 26 1957
CONSERVATION DIVISION
Wichita, Kansas

12-26-57

(If additional description is necessary, use BACK of this sheet)
Name of Plugging Contractor Falcon Seaboard Drilling Company
Address Pan American Building, Tulsa, Oklahoma

STATE OF Kansas, COUNTY OF Sedgwick, ss.
Thomas A. Trax (employee of owner) or (owner or operator) of the above-described well, being first duly sworn on oath, says: That I have knowledge of the facts, statements, and matters herein contained and the log of the above-described well as filed and that the same are true and correct. So help me God.

(Signature) *Thomas A. Trax*
Box 2233, Wichita, Kansas
(Address)

SUBSCRIBED AND SWORN TO before me this 23rd day of December 19 57.
C. C. Lewis
Notary Public.

My commission expires 6-3-61
C. C. LEWIS, NOTARY PUBLIC

JRM:PF

PLUGGING
FILE SEC 29 T. 28 R. 18W
BOOK PAGE 69 LINE 31

15-097-00135-0000

WELL RECORD

COMPANY: Gulf Oil Corporation

Sec. 29-28S-18W

FARM: Otto Weide No. 1

Loc. NW SE

TOTAL DEPTH: 5010'

County - Kiowa

COMM: 11-27-57. COMP: 12-15-57.

CASING

ELEVATION

8-5/8" - 582'

D.F. -

Gr. -

DRILLER'S LOG

Clay & Shale	0	441
Clay & Red Bed	441	819
Shale	819	1122
Lime & Shale	1122	2315
Lime	2315	2544
Lime & Shale	2544	2646
Lime	2646	2850
Lime & Shale	2850	3555
Lime	3555	3640
Lime & Shale	3640	3922
Lime	3922	4068
Lime & Shale	4068	4310
Lime	4310	4920
Chert	4920	4948
Lime	4948	5010
Total Depth		5010

RECEIVED
STATE CORPORATION COMMISSION

DEC 26 1957

CONSERVATION DIVISION
Wichita, Kansas

PLUGGING
FILE - SEC 29 T 28 R 18W
BOOK PAGE 69 LINE 31