


Give All Information Completely
Make Required Affidavit
Mail or Deliver Report to:
Conservation Division
State Corporation Commission
P. O. Box 17027
Wichita, Kansas 67217
NORTH

WELL PLUGGING RECORD

Kiowa County. Sec. 17 Twp. 28S Rge. (E) 18W (W)
Location as "NE/CNW/SW" or footage from lines C SW NW
Lease Owner Pickrell Drilling Company
Lease Name Kerr "A" Well No. 1
Office Address 705 Fourth National Bank Bldg., Wichita, Ks. 67202
Character of Well (completed as Oil, Gas or Dry Hole) Dry Hole
Date well completed April 26 19 74
Application for plugging filed April 26 19 74
Application for plugging approved April 26 19 74
Plugging commenced April 26 19 74
Plugging completed April 26 19 74
Reason for abandonment of well or producing formation Dry Hole

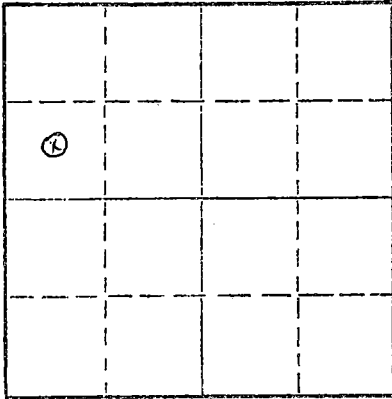

Locate well correctly on above Section Plat

If a producing well is abandoned, date of last production 19
Was permission obtained from the Conservation Division or its agents before plugging was commenced? Yes

Name of Conservation Agent who supervised plugging of this well G. R. Biberstein, Attica, Ks.
Producing formation _____ Depth to top _____ Bottom _____ Total Depth of Well 4925 Feet
Show depth and thickness of all water, oil and gas formations.

OIL, GAS OR WATER RECORDS

CASING RECORD

FORMATION	CONTENT	FROM	TO	SIZE	PUT IN	PULLED OUT
				8 5/8"	238'	None

RECEIVED
STATE CORPORATION COMMISSION
MAY 3 - 1974
CONSERVATION DIVISION
Wichita, Kansas

5-3-74

Describe in detail the manner in which the well was plugged, indicating where the mud fluid was placed and the method or methods used in introducing it into the hole. If cement or other plugs were used, state the character of same and depth placed, from _____ feet to _____ feet for each plug set.

Bottom Plug set at 230' with 35 sacks cement

Top Plug set at 40' with 15 sacks cement.

Completed at 3:30 PM April 26, 1974.

(If additional description is necessary, use BACK of this sheet)

Name of Plugging Contractor Pickrell Drilling Company
Address 705 Fourth National Bank Bldg., Wichita, Ks. 67202

STATE OF KANSAS, COUNTY OF SEDGWICK, ss.
C. W. Sebitts (employee of owner) or (owner or operator) of the above-described well, being first duly sworn on oath, says: That I have knowledge of the facts, statements, and matters herein contained and the log of the above-described well as filed and that the same are true and correct. So help me God.

(Signature) *C. W. Sebitts*
C. W. Sebitts
705 Fourth National Bank Bldg., Wichita, Ks.
(Address)

SUBSCRIBED AND SWORN TO before me this 1st day of May, 19 74

My commission expires August 19, 1975

Helen L. Martin
Helen L. Martin
Notary Public.

ROTARY DRILLING LOG

15-097-20213-0000

COMPANY: Pickrell Drilling Company
705 Fourth National Bank Bldg.
Wichita, Kansas 67202

LOCATION: Kerr "A" No. 1
C SW NW Section 17-28S-18W
Kiowa County, Kansas

Rotary Drilling Commenced 4/10/74
Rotary Drilling Completed 4/25/74

CONTRACTOR: **PICKRELL DRILLING COMPANY**
Wichita, Kansas

CASING RECORD: (7 jts.) 8 5/8" surface casing set at 238' KB and cemented with 185 sacks cement. Circulated. Completed April 10, 1974, at 3:30 P.M. D. & A., plugged April 26, 1974, completed 3:30 P.M.

LOG

(Figures indicate bottom of formation — measurements from top of rotary bushing.)

140	Top Soil and Sand	C. F. S.
240	Shale	2520
575	Red Bed & Shale	2575
610	Shale & Mica	2627
1153	Shale	3025
1183	Anhydrite	3155
1790	Shale	3182
2305	Shale, Shells & Sand Stks.	3210
2345	Lime & Shale Strks.	3530
3155	Lime & Shale	3664
3265	Lime & Shale Strks.	4303
3355	Lime & Shale	4360
3465	Shale	4435
3555	Shale & Lime Stks.	4536
3795	Lime & Shale	4630
3915	Lime & Shale, Topeka	4630
4050	Lime, Shale, Chalk	4862
4240	Lime & Chalk	4874
4303	Lansing	4885
4395	Lime & Shale	
4565	Lime, Shale, Chert & Chalk	
4667	Lime, Chalk, Chert, Shale Strks.	
4825	Lime & Shale	S. L. M.
4847	Top Mississippi	Board 4823.01
4916	Mississippi	Strap 4816.87
4925	Lime, Chert, Shale, RTD	Diff. 6.14

RECEIVED
STATE CORPORATION COMMISSION
MAY 3 - 1974
CONSERVATION DIVISION
Wichita, Kansas

Slope Tests

2500
3000
3500
4000
4500

The undersigned, C. W. SEBITS, Attorney-in-Fact for PICKRELL DRILLING COMPANY, hereby certifies in behalf of said Company, that the above is a true and correct log of the formation encountered in drilling the above well as reflected by the Daily Drilling Reports.

PICKRELL DRILLING COMPANY
By [Signature]
C. W. Sebitts Attorney-in-Fact

STATE OF KANSAS }
COUNTY OF SEDGWICK } ss.:

On this 1st day of May, 19 74, before me the undersigned, a Notary Public, in and for the County and State aforesaid, personally appeared C. W. Sebitts, to me known to be the identical person who subscribed the name of PICKRELL DRILLING COMPANY to the foregoing instrument as its Attorney-in-Fact and acknowledged to me that he executed the same as his free and voluntary act and deed, and as the free and voluntary act and deed of such company, for the uses and purposes therein set forth.

Given under my hand and seal of office the day and year last above written.

My commission expires: August 19, 1975
Helen L. Martin
Helen L. Martin Notary Public