

Give All Information Completely
Make Required Affidavit
Mail or Deliver Report to:
Conservation Division
State Corporation Commission
212 No. Market
Wichita, Kansas

WELL PLUGGING RECORD

Kiowa County. Sec. 2 Twp. 28S Rge. (E) 17 (W)

Location as "NE/CNW/SW" or footage from lines C SW SW

Lease Owner KWB Oil Property Management, Inc.

Lease Name Ester M. Davis Well No. 1

Office Address 1125 National Bank of Tulsa Bldg., Tulsa, Okla.

Character of Well (completed as Oil, Gas or Dry Hole) Dry Hole

Date well completed Nov. 19, 1969

Application for plugging filed (letter 11/20/69) Nov. 19, 1969

Application for plugging approved Nov. 19, 1969


Plugging commenced Nov. 19, 1969

Plugging completed Nov. 19, 1969

Reason for abandonment of well or producing formation _____

If a producing well is abandoned, date of last production 19

Was permission obtained from the Conservation Division or its agents before plugging was commenced? Yes

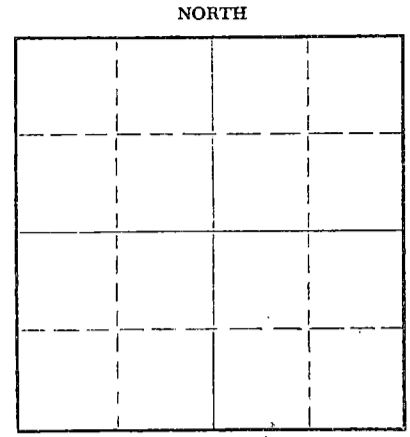

Locate well correctly on above Section Plat

Name of Conservation Agent who supervised plugging of this well Herman Justice

Producing formation _____ Depth to top _____ Bottom _____ Total Depth of Well 4992 Feet

Show depth and thickness of all water, oil and gas formations.

OIL, GAS OR WATER RECORDS

CASING RECORD

| FORMATION | CONTENT | FROM | TO | SIZE | PUT IN | PULLED OUT |
|--|---------|------|------|--------|--------|------------|
| | | 0 | 281' | 8-5/8" | 281' | None |
| <p>RECEIVED STATE CORPORATION COMMISSION NOV 21 1969 CONSERVATION DIVISION Wichita, Kansas</p> <p>11-21-69</p> | | | | | | |
| | | | | | | |
| | | | | | | |
| | | | | | | |
| | | | | | | |
| | | | | | | |
| | | | | | | |
| | | | | | | |
| | | | | | | |

Describe in detail the manner in which the well was plugged, indicating where the mud fluid was placed and the method or methods used in introducing it into the hole. If cement or other plugs were used, state the character of same and depth placed, from _____ feet to _____ feet for each plug set.

Filled hole with heavy mud to 240 feet. Set first plug @ 240 feet w/25 sacks cement.
Filled hole with heavy mud to 40 feet. Set second plug @ 40 feet w/1/2 sack hulls and 10 sacks cement. Plugged rat hole with 3 sacks cement. Job complete @ 10:15 AM, 11/19/69.

(If additional description is necessary, use BACK of this sheet)

Name of Plugging Contractor Gabbert-Jones, Inc.
Address 830 Sutton Place - Wichita, Kansas 67202

STATE OF Kansas, COUNTY OF Sedgwick, ss.
E. E. Hall (employee of owner) or (owner or operator) of the above-described well, being first duly sworn on oath, says: That I have knowledge of the facts, statements, and matters herein contained and the log of the above-described well as filed and that the same are true and correct. So help me God.


(Signature) E E Hall

830 Sutton Place, Wichita, Kansas 67202
(Address)

SUBSCRIBED AND SWORN to before me this 20 day of November, 19 69

Feb. 1, 1972

Barbara J. Layton
Barbara J. Layton Notary Public.

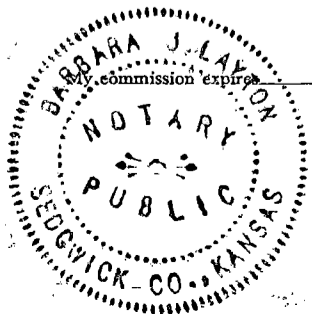

GABBERT-JONES, INC.
WICHITA, KANSAS
DRILLERS' WELL LOG

ESTER M. DAVIS #1
C SW SW Section 2-28-17W
Kiowa County, Kansas

Commenced: November 6, 1969
Completed: November 19, 1969

OPERATOR - KWB Oil Property Management, Inc.

| DEPTH | | FORMATION | REMARKS |
|-------|------|-------------------|---|
| From | To | | |
| 0 | 160 | Sand | |
| 160 | 281 | Shale | Ran 7 joints of 8-5/8" casing, set @ 281' w/250 sacks cement. |
| 281 | 480 | Shale and red bed | |
| 480 | 1062 | Shale | |
| 1062 | 1082 | Anhydrite | |
| 1082 | 1885 | Shale and red bed | |
| 1885 | 3605 | Shale and lime | |
| 3605 | 3765 | Lime | |
| 3765 | 4356 | Lime and shale | |
| 4356 | 4802 | Lime | |
| 4802 | 4858 | Chert and lime | |
| 4858 | 4992 | Lime | |
| 4992 | TD | | Dry and abandoned. |

RECEIVED
STATE CORPORATION COMMISSION
NOV 21 1969
CONSERVATION DIVISION
Wichita, Kansas

I, E. E. HALL, certify this is a correct copy of the Drillers' Log for the well drilled in the C SW SW Section 2-28-17W, Kiowa County, Kansas, to the best of my knowledge and belief.

E. E. Hall

E. E. HALL

STATE OF KANSAS)
) SS
COUNTY OF SEDGWICK)

Before me, the undersigned, a Notary Public within and for said County and State, on this 20 day of November, 1969, personally appeared E. E. Hall to me personally known to be the identical person who executed the within and foregoing instrument and acknowledged to me that he executed the same as his free and voluntary act and deed for the uses and purposes therein set forth.

IN WITNESS WHEREOF, I have hereunto set my hand and official seal the day and year last above written.

My Commission Expires Feb. 1, 1972.

Barbara J. Layton
Barbara J. Layton, Notary Public

