

STATE OF KANSAS
STATE CORPORATION COMMISSION


Give All Information Completely
Make Required Affidavit
Mail or Deliver Report to:
Conservation Division
State Corporation Commission
212 No. Market
Wichita, Kansas

WELL PLUGGING RECORD

Kiowa County, Sec. 31 Twp. 28S Rge. 16W ~~16E~~ (W)

Location as "NE/CNW/SW" or footage from lines NE NE NE
Lease Owner Patrick Petroleum Corporation
Lease Name Hamilton Well No. 1
Office Address 330 Page Court, 220 W. Douglas, Wichita, Kansas
Character of Well (completed as Oil, Gas or Dry Hole) Dry Hole
Date well completed October 2, 19 74
Application for plugging filed October 2, 19 74
Application for plugging approved October 2, 19 74
Plugging commenced October 2, 19 74
Plugging completed October 2, 19 74
Reason for abandonment of well or producing formation Dry Hole

NORTH

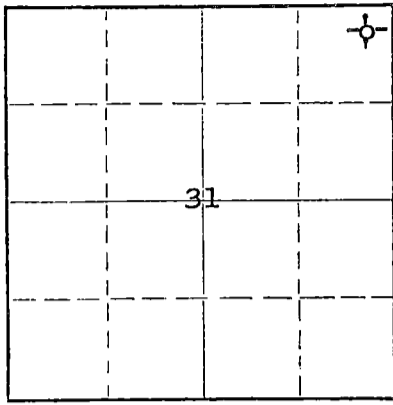

Locate well correctly on above
Section Plat

If a producing well is abandoned, date of last production _____ 19____
Was permission obtained from the Conservation Division or its agents before plugging was commenced? Yes

Name of Conservation Agent who supervised plugging of this well _____
Producing formation _____ Depth to top _____ Bottom _____ Total Depth of Well 3900 Feet
Show depth and thickness of all water, oil and gas formations.

OIL, GAS OR WATER RECORDS

CASING RECORD

FORMATION	CONTENT	FROM	TO	SIZE	PUT IN	PULLED OUT
		0'	417'	8-5/8"	417'	None

Describe in detail the manner in which the well was plugged, indicating where the mud fluid was placed and the method or methods used in introducing it into the hole. If cement or other plugs were used, state the character of same and depth placed, from _____ feet to _____ feet for each plug set.

3900-1300' - Mud
300'-296' - Plug
296'-40' - Cement, 35 sacks
40'-36' - Plug
36'-6' - Cement, 15 sacks (Bottom of cellar)
2 sacks cement in rat hole.

RECEIVED
STATE CORPORATION COMMISSION

OCT 9 1974 10-9-74

CONSERVATION DIVISION
Wichita, Kansas

(If additional description is necessary, use BACK of this sheet)

Name of Plugging Contractor Halliburton Cementing Co.
Address Great Bend, Kansas

STATE OF KANSAS, COUNTY OF SEDGWICK, ss.
John H. Knightley, Agent ~~employee of owner~~ ~~owner or operator~~ of the above-described well, being first duly sworn on oath, says: That I have knowledge of the facts, statements, and matters herein contained and the log of the above-described well as filed and that the same are true and correct. So help me God.

(Signature) John H. Knightley
301 S. Broadway, Wichita, Kansas
(Address)

SUBSCRIBED AND SWORN to before me this 8th day of October, 19 74

My commission expires March 12, 1975
Stella J. Lips Notary Public.

15-097-20254-0000

Patrick Petroleum Corporation - Hamilton #1
NE NE NE Sec. 31-28S-16W
Kiowa County, Kansas

Contractor: D. R. Lauck Oil Company, Inc.
301 S. Broadway
Wichita, Kansas 67202

Commenced: September 24, 1974
Completed: October 2, 1974

Drillers Log

Clay	60
Sand	200
Shale	330
Sand	370
Shale	406
Gyp	418
Shale & Shells	1035
Anhydrite	1067
Shale & Shells	1110
Shale	1785
Shale & Lime	2165
Lime & Shale	3900 RTD

RECEIVED
STATE CORPORATION COMMISSION

OCT 9 1974

CONSERVATION DIVISION
Wichita, Kansas