


STATE OF KANSAS
STATE CORPORATION COMMISSION

WELL PLUGGING RECORD

Give All Information Completely
Make Required Affidavit
Mail or Deliver Report to
Conservation Division
State Corporation Comm.
245 North Water
Wichita, KS 67202

Kingman County. Sec. 15 Twp. 29 Rge. 9 E/W
Location as "NE/CNW $\frac{1}{4}$ SW $\frac{1}{4}$ " or footage from lines _____
C NE NE
Lease Owner A. Scott Ritchie
Lease Name Govert #1 Well No. _____
Office Address Wichita, Kansas
Character of Well (Completed as Oil, Gas or Dry Hole) _____

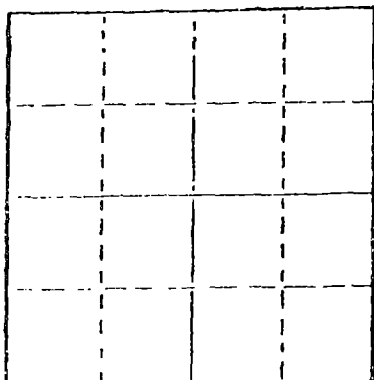

Locate well correctly on above Section Plat

Date Well completed _____ 19____
Application for plugging filed _____ 19____
Application for plugging approved _____ 19____
Plugging commenced 7/20/77 _____ 19____
Plugging completed 7/22/77 _____ 19____
Reason for abandonment of well or producing formation
depleted.
If a producing well is abandoned, date of last production _____ 19____

Was permission obtained from the Conservation Division or its agents before plugging was commenced? yes

Name of Conservation Agent who supervised plugging of this well Metz
Producing formation _____ Depth to top _____ Bottom _____ Total Depth of Well 2490
Show depth and thickness of all water, oil and gas formations.

OIL, GAS OR WATER RECORDS

CASING RECORD

FORMATION	CONTENT	FROM	TO	SIZE	PUT IN	PULLED OUT
				8-5/8	228	none
				4 1/2"	2485	2000'

Describe in detail the manner in which the well was plugged, indicating where the mud fluid was placed and the method or methods used in introducing it into the hold. If cement or other plugs were used, state the character of same and depth placed, from _____ feet to _____ feet for each plug set.

Sanded to 2350' and ran 4 sacks cement. Loaded hole, shot pipe at 1994', pulled 62 joints. Bailed hole to 220', set rock bridge and ran 4 yards ready mix.

PLUGGING COMPLETE.

RECEIVED
STATE CORPORATION COMMISSION
JUL 27 1977 7-27-77

(If additional description is necessary, use BACK of this sheet)

Name of Plugging Contractor KELSO CASING PULLING
CHASE, KANSAS

STATE OF KANSAS COUNTY OF RICE, ss.
R. DARRELL KELSO (employee of owner) or (owner or operator)
of the above-described well, being first duly sworn on oath, says: That I have knowledge of the facts, statements, and matters herein contained and the log of the above-described well as filed and that the same are true and correct. So help me God.

(Signature) R. Darrell Kelso
CHASE, KANSAS
(Address)

SUBSCRIBED AND SWORN TO before me this 25th day of July, 19 77

Margaret Melcher
Notary Public.

My commission expires _____



ROTARY DRILLERS' LOG

OPERATOR: A. Scott Ritchie
412 Union Center
Wichita, Kansas

COMMENCED DRILLING: 7/7/71

CONTRACTOR: Graves Drilling Co., Inc.
505 Union Center
Wichita, Kansas

COMPLETED DRILLING: 7/11/71

SURFACE CASING: 8 joints used 8 5/8"
Cemented with 215 sacks

LOCATION: Govert # 1
C. NE NE
Section 15-29-9W
Kingman County, Ks.

0	-	97	sand
97	-	228	redbed
228	-	1350	redbed & shale
1350	-	1745	lime & shale
1745	-	1875	lime
1875	-	2210	lime & shale
2210	-	2394	lime
2394	-	2450	sand
2450	-	2490	lime

RECEIVED
GENERAL INVESTIGATION COMMISSION
JUN 22 1977
GENERAL INVESTIGATION
COMMISSION
WICHITA, KANSAS

I hereby certify the foregoing statement to be correct to the best of my knowledge.

John C. Graves

John C. Graves, President

STATE of KANSAS)
COUNTY OF SEDGWICK)

ss

Subscribed and sworn before me, a notary public, this 19th day of July, 1971.

Mary Ann Scott

Mary Ann Scott, Notary Public

My commission expires July 28, 1974

