

STATE OF KANSAS
STATE CORPORATION COMMISSION

Give All Information Completely
Make Required Affidavit
Mail or Deliver Report to:
Conservation Division
State Corporation Commission
800 Biting Building
Wichita, Kansas

WELL PLUGGING RECORD

Kiowa County. Sec. 9 Twp. 29S Rge. 16W (E) (W)

Location as "NE/CNW%SW%" or footage from lines SE SE SE

Lease Owner Falcon Seaboard Drilling Company

Lease Name E. M. Pyle Well No. 1

Office Address Oklahoma City, Oklahoma

Character of Well (completed as Oil, Gas or Dry Hole) Dry Hole

Date well completed April 28 1955

Application for plugging filed June 7 1955

Application for plugging approved June 8 1955


Plugging commenced August 16 1955

Plugging completed August 22 1955

Reason for abandonment of well or producing formation _____

If a producing well is abandoned, date of last production _____ 19____

Was permission obtained from the Conservation Division or its agents before plugging was commenced? Yes

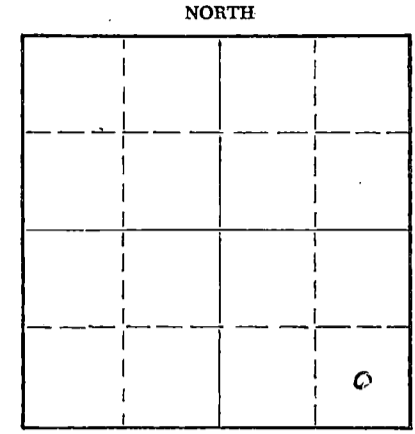

Locate well correctly on above Section Plat

Name of Conservation Agent who supervised plugging of this well Merle Rives

Producing formation _____ Depth to top _____ Bottom _____ Total Depth of Well 4742 Feet

Show depth and thickness of all water, oil and gas formations.

OIL, GAS OR WATER RECORDS

CASING RECORD

FORMATION	CONTENT	FROM	TO	SIZE	PUT IN	PULLED OUT
				10-3/4"	345'	None
				7" OD	4742'	4281'
				Plug set at 4702' and casing perforated from 4646' to 4666'.		

Describe in detail the manner in which the well was plugged, indicating where the mud fluid was placed and the method or methods used in introducing it into the hole. If cement or other plugs were used, state the character of same and depth placed, from _____ feet to _____ feet for each plug set.

Filled the hole with sand from 4702' to 4635' and ran 5 sacks of cement. Pulled casing to 1500' and circulated casing with mud. Bailed mud to 345', set a 10' rock bridge and ran 20 sacks of cement. Mudded the hole to 25', set a 10' rock bridge and ran 10 sacks of cement on top. Plugging completed.

(If additional description is necessary, use BACK of this sheet)
Name of Plugging Contractor West Supply Co., Inc.
Address Chase, Kansas

STATE OF OKLAHOMA, COUNTY OF TULSA, ss.
J. O. Brown (employee of owner) or (owner or operator) of the above-described well, being first duly sworn on oath, says: That I have knowledge of the facts, statements, and matters herein contained and the log of the above-described well as filed and that the same are true and correct. So help me God.

(Signature) FALCON SEABOARD DRILLING COMPANY
By J. O. Brown (Address)

SUBSCRIBED AND SWORN to before me this 29th day of August, 1955

Dolores Welch
Notary Public.

My commission expires February 8, 1958

PLUGGING
PAGE SEC 9 T. 29 R. 16W
BOOK PAGE 26 LINE 13

RECORDED
INDEXED
AUG 30 1955 8-30-55
CONSERVATION DIVISION
Wichita, Kansas

WELL LOG

COMPANY - FALCON SEABOARD DRILLING CO.

Sec. 9, T. 29S, R. 16W
Loc. C SE SE SE
COUNTY - KIOWA

FARM - E. M. PYLE NO. 1

TOTAL DEPTH - 4742

COMM. - 3-28-55 COMP. - 4-17-55

CONTRACTOR - COMPANY TOOLS

ELEVATION

CASING

K.B. - 2031

10-3/4" - 345'

D.F. - 2028

7" - 4742'

Gr. - 2021

DRILLER'S LOG

Gravel & Red Bed	0	200
Red Bed & Lime Shells	200	450
Red Bed	450	750
Red Bed & Shale	750	1250
Shale & Lime Shells	1250	1550
Red Bed & Shells	1550	1850
Shale & Lime	1850	2135
Lime & Sand	2135	2223
Shale & Sdy. Lime	2223	2325
Sdy. Lime	2325	2402
Lime & Shale	2402	2512
Lime & Sdy. Lime	2512	2585
Lime	2585	2665
Lime & Shale	2665	2713
Lime	2713	2770
Lime & Shale	2770	3320
Lime	3320	3370
Lime & Shale	3370	3442
Lime	3442	3553
Shale & Lime	3553	3815
Lime, Sdy. Lime & Shale	3815	3897
Shale & Sdy. Lime	3897	3942
Lime & Shale	3942	4021
Shale	4021	4104
Lime	4104	4119
Lime & Shale	4119	4175
Lime	4175	4328
Lime & Shale	4328	4370
Lime	4370	4472
Lime & Shale	4472	4651
Lime	4651	4676
Chert	4676	4678
Lime, Chert & Shale	4678	4710
Chert & Lime	4710	4742
Total Depth	4742	

PLUGGING

FILE SEC 9 T 29 R 16 W
BOOK PAGE 65 LINE 13

RECEIVED
STATE COMMISSION

APR 10 1955

CONSERVATION DIVISION
Wichita, Kansas