


STATE OF KANSAS  
STATE CORPORATION COMMISSION

WELL PLUGGING RECORD

Give All Information Completely  
Make Required Affidavit  
Mail or Deliver Report to  
Conservation Division  
State Corporation Comm.  
245 North Water  
Wichita, KS 67202

Pratt County. Sec. 35 Twp. 28S Rge. 14W E/W  
Location as "NE/CNW $\frac{1}{4}$ SW $\frac{1}{4}$ " or footage from lines C-E/2 NE/4

Lease Owner Ronald Russ Prater, Inc.  
Lease Name Omo "A" Well No. 1  
Office Address 240 N. Rock Rd.-Suite 235, Wichita, KS  
Character of Well (Completed as Oil, Gas or Dry Hole) 67206

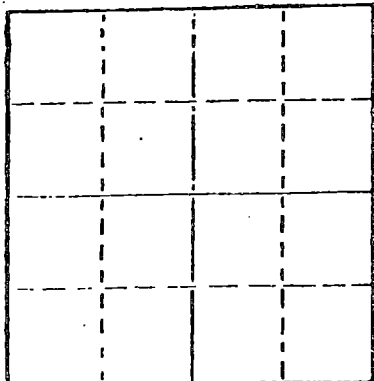

Locate well correctly on above  
Section Plot

Dry Hole  
Date Well completed November 11, 1978  
Application for plugging filed Verbal Application 1978  
Application for plugging approved Verbal Approval 1978  
Plugging commenced November 11, 1978  
Plugging completed November 11, 1978  
Reason for abandonment of well or producing formation \_\_\_\_\_

If a producing well is abandoned, date of last production 1978

Was permission obtained from the Conservation Division or its agents before plugging was commenced? Yes

Name of Conservation Agent who supervised plugging of this well Wm. T. Owen  
Producing formation \_\_\_\_\_ Depth to top \_\_\_\_\_ Bottom \_\_\_\_\_ Total Depth of Well 2,991'  
Show depth and thickness of all water, oil and gas formations.

OIL, GAS OR WATER RECORDS

CASING RECORD

FORMATION	CONTENT	FROM	TO	SIZE	PUT IN	PULLED OUT
				8-5/8"	330'	None

Describe in detail the manner in which the well was plugged, indicating where the mud fluid was placed and the method or methods used in introducing it into the hold. If cement or other plugs were used, state the character of same and depth placed, from \_\_\_\_\_ feet to \_\_\_\_\_ feet for each plug set.

Filled hole with heavy rotary mud from 2,991 ft. (rotary total depth) to 540 ft. Set plug at 540 ft. and cemented with 40 sacks cement. Filled hole with heavy rotary mud from 540 ft. to 330 ft. Set plug at 330 ft. and cemented with 40 sacks cement. Filled hole with heavy rotary mud from 330 ft. to 40 ft. Set solid plug at 40 ft. and cemented to cellar with 12 sacks cement, 3 sacks cement in rat hole.

Plugging operations accomplished utilizing Allied Oil Well cementing pump truck through 4 1/2 inch drill pipe.

(If additional description is necessary, use BACK of this sheet)


Name of Plugging Contractor Allied Cementing Co., Inc.  
Box 31, Russell, Kansas 67665

STATE OF Kansas COUNTY OF Sedgwick, ss.  
Dean Britting, Agent ~~XXXXXX~~ of owner ~~XXXXXXXXXXXXXXXXXXXX~~

of the above-described well, being first duly sworn on oath, says: That I have knowledge of the facts, statements, and matters herein contained and the log of the above-described well as filed and that the same are true and correct. So help me God.

(Signature) Dean Britting  
200 N. Main, Wichita, Kansas 67202  
(Address)

SUBSCRIBED AND SWORN TO before me this 15th day of November, 1978

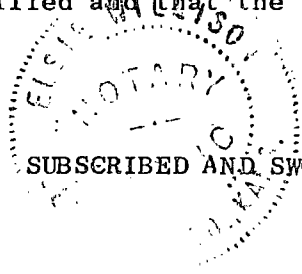

Elsie Willison  
Elsie Willison - Notary Public.

My commission expires July 25, 1982

RECEIVED  
STATE CORPORATION COMMISSION

NOV 15 1978  
11-16-78  
CONSERVATION DIVISION  
WICHITA, KANSAS

KANSAS DRILLERS LOG

COMPANY Ronald Russ Prater, Inc.

SEC. 35 T. 20S R. 14W  
LOP. C-E/2 NE/4

FARM OMO "A" NO. 1

COUNTY Pratt

ROTARY TOTAL DEPTH 2,991'  
COMM. November 7, 1978 COMP. November 11, 1978  
CONTRACTOR H-30, Inc. (Rig #3)  
ISSUED November 15, 1978

CASING

10 3/4"  
8 5/8" Set at 330' cemented w/250 lbs cement  
5 1/2"  
4 1/2"

ELEVATION 1,986' K.B.

FIGURES INDICATE BOTTOM OF FORMATIONS

Sand	165'
Red Bed and Shale	334'
Shale and Lime	2,067'
Lime and Shale	2,196'
Shale and Lime	2,525'
Lime and Shale	2,750'
Shale and Lime	2,991'
Rotary Total Depth	2,991'

I hereby certify the above and foregoing to be a true and correct log of the above described well as shown by the drilling reports.

H-30, Inc.

*Dean Britting*  
\_\_\_\_\_  
Dean Britting

State of Kansas )  
County of Sedgwick ) ss:

Subscribed and Sworn to before me a Notary Public in and for said county and state this 15th day of

November, 1978.



*Elsie Willison*  
\_\_\_\_\_  
Elsie Willison - Notary Public

My Commission Expires:

July 25, 1982

RECEIVED  
STATE CORPORATION COMMISSION  
NOV 16 1978  
CONSERVATION DIVISION  
Wichita, Kansas