


STATE OF KANSAS
STATE CORPORATION COMMISSION

Form CP-4

Give All Information Completely
Make Required Affidavit
Mail or Deliver Report to:
Conservation Division
State Corporation Commission
212 No. Market
Wichita, Kansas

WELL PLUGGING RECORD

15' West #1

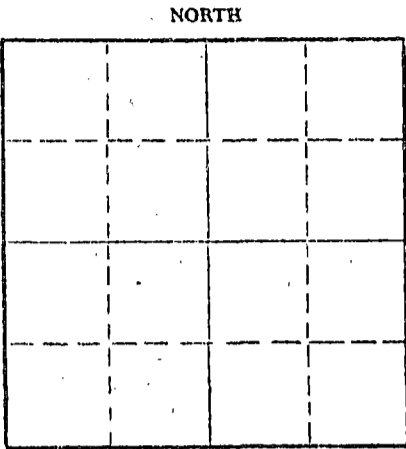

Locate well correctly on above
Section Plat

Pratt County, Sec. 35 Twp. 28S Rge. 14W (E) (W)
Location as "NE/CNW/SW" or footage from lines SE SE NE
Lease Owner National Associated Petroleum Co.
Lease Name Elsie Omo Well No. 1-A
Office Address 502 Ritz Bldg. - Tulsa, Oklahoma
Character of Well (completed as Oil, Gas or Dry Hole) D & A
Date well completed January 14, 1967
Application for plugging filed January 14, 1967
Application for plugging approved January 14, 1967
Plugging commenced January 14, 1967
Plugging completed January 14, 1967
Reason for abandonment of well or producing formation D & A

If a producing well is abandoned, date of last production 19
Was permission obtained from the Conservation Division or its agents before plugging was commenced? Yes

Name of Conservation Agent who supervised plugging of this well Archie Elving (state plugger)
Producing formation Depth to top Bottom Total Depth of Well 4646 Feet
Show depth and thickness of all water, oil and gas formations.

OIL, GAS OR WATER RECORDS

CASING RECORD

FORMATION	CONTENT	FROM	TO	SIZE	PUT IN	PULLED OUT
				8 5/8"	308'	-0-

Describe in detail the manner in which the well was plugged, indicating where the mud fluid was placed and the method or methods used in introducing it into the hole. If cement or other plugs were used, state the character of same and depth placed, from feet to feet for each plug set.

Mud to 300'. Bridge
w/2 sx dry cement. Set
plug w/ hulls & 23 sx
cement. Mud to 40'.
2 sx dry cement. Set
plug w/ hulls & 8 sx
cement. 2 sx cement
in rathole.

RECEIVED
STATE CORPORATION COMMISSION
JAN 28 1967
1-23-67
CONSERVATION DIVISION
Wichita, Kansas

(If additional description is necessary, use BACK of this sheet)

Name of Plugging Contractor Red Tiger Drilling Company
Address 1720 Wichita Plaza - Wichita, Kansas

STATE OF KANSAS, COUNTY OF SEDGWICK, ss.
Maxine V. Starr (employee of owner) or (owner/operator) of the above-described well, being first duly sworn on oath, says: That I have knowledge of the facts, statements, and matters herein contained and the log of the above described well as filed and that the same are true and correct. So help me God.

(Signature) Maxine V. Starr
1720 Wichita Plaza - Wichita, Kansas
(Address)

SUBSCRIBED AND SWORN TO before me this 18th day of January, 1967

Jean Holler
Notary Public.

My commission expires 5-22-70

DRILLERS LOG

Elsie Omo No. *D 1-A* *12 feet West #1*


CASING RECORD:	COMPANY:	National Assoc. Pet. Co.	DESCRIPTION:
8 5/8" @ 308'	CONTRACTOR:	Red Tiger Drilling Co.	SE SE NE
w/250 sx cement	COMMENCED:	January 1, 1967	35-28S-14W
	COMPLETED:	January 14, 1967	Pratt Co., Ks.
			ELEVATION: 1981 DF
			1984 RB
TOTAL DEPTH: 4646'			

<u>FORMATION</u>	<u>FROM</u>	<u>TO</u>	<u>REMARKS</u>
Surf. Soil & Sandy Clay	0	30	
Sand & Gravel	30	191	
Red Bed & Shale	191	309	
Red Bed	309	810	
Anhydrite	810	818	
Shale & Shells	818	1918	
Lime & Shale	1918	3244	
Lime	3244	3385	
Shale & Lime	3385	3610	
Lime	3610	3695	
Lime & Shale	3695	3949	
Lime	3949	3955	
Brown Lime	3955	3970	
Lansing	3970	3995	
Lime	3995	4300	
B/KC	4300	4326	
Shale & Lime	4326	4343	
Lime	4343	4403	
Cherty Lime & Shale	4403	4520	
Simpson	4520	4525	
Sandy Shale	4525	4535	
Shale w/trace Dob.	4535	4618	
Arb.	4618	4646	

RECEIVED
 STATE CORPORATION COMMISSION
 JAN 28 1967
 CONSERVATION DIVISION
 WICHITA, KANSAS

I certify that this is a true and correct copy of the above log to the best of my knowledge.

RED TIGER DRILLING COMPANY


 Maxine V. Starr

Subscribed and sworn to before me this 18th day of January, 1967.


 Notary Public

My Commission Expires:

5-22-70