


Give All Information Completely
Make Required Affidavit
Mail or Deliver Report to:
Conservation Division
State Corporation Commission
211 No. Broadway
Wichita, Kansas

WELL PLUGGING RECORD

NORTH

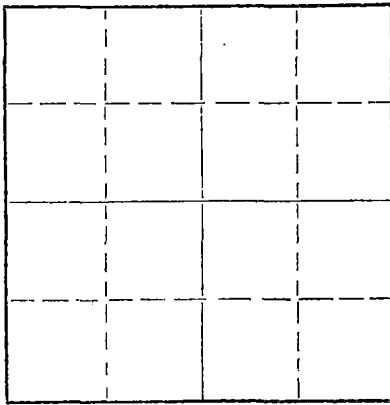

Locate well correctly on above
Section Plat

Pratt County. Sec. 35 Twp. 28S Rge. (X) 14(w)
Location as "NE/CNW $\frac{1}{2}$ SW $\frac{1}{2}$ " or footage from lines SE NW NE
Lease Owner Mayflo Oil Company
Lease Name Omo Well No. 1-35
Office Address Republic Natl. Bank Bldg. Dallas 1, Texas
Character of Well (completed as Oil, Gas or Dry Hole) Dry Hole
Date well completed September 25th, 19 63
Application for plugging filed 19
Application for plugging approved 19
Plugging commenced 11 PM, September 24th, 19 63
Plugging completed 4 AM, September 25th, 19 63
Reason for abandonment of well or producing formation No producible shows.

If a producing well is abandoned, date of last production -- 19 --
Was permission obtained from the Conservation Division or its agents before plugging was commenced? Yes

Name of Conservation Agent who supervised plugging of this well Archie V. Elving, Pratt, Kansas
Producing formation -- Depth to top -- Bottom -- Total Depth of Well 4497 Feet
Show depth and thickness of all water, oil and gas formations.

OIL, GAS OR WATER RECORDS

CASING RECORD

FORMATION	CONTENT	FROM	TO	SIZE	PUT IN	PULLED OUT
		0'	790'	8 5/8"	790'	None

Describe in detail the manner in which the well was plugged, indicating where the mud fluid was placed and the method or methods used in introducing it into the hole. If cement or other plugs were used, state the character of same and depth placed, from -- feet to -- feet for each plug set.

Heavy mud to 300', pushed wooden plug to 300', added 1/2 sx hulls, and 25 sx cement. Heavy mud to 40', pushed wooden plug to 40', added 1/4 sx hulls, and 10 sx cement to bottom of cellar. Bridged rat hole and added 2 sx cement. Bridged mouse hole and added 2 sx cement.
Job Complete 4 AM, 9-25-63.

RECEIVED
STATE CORPORATION COMMISSION

OCT 4 1963
10-4-63

CONSERVATION DIVISION
WICHITA, KANSAS

(If additional description is necessary, use BACK of this sheet)
Name of Plugging Contractor Garvey Drilling Company
Address RR #2 Great Bend, Kansas

STATE OF Kansas, COUNTY OF Barton, ss.

Garvey Drilling Company (employee of owner) or (owner or operator) of the above-described well, being first duly sworn on oath, says: That I have knowledge of the facts, statements, and matters herein contained and the log of the above-described well as filed and that the same are true and correct. So help me God:

(Signature) *Sam N. Stephens*

RR #2

(Address)

SUBSCRIBED AND SWORN TO before me this 30th day of September, 19 63

Arthur J. Wiles

Notary Public.

My commission expires April 14th, 1967