

Prod

PEACHEY #1
ACO-1 WELL HISTORY

AFFIDAVIT OF COMPLETION FORM

TYPE

Compt. _____

SIDE ONE

Two (2) copies of this form shall be filed with the Kansas Corporation Commission, 200 Colorado Derby Building, Wichita, Kansas 67202, within thirty (30) days after the completion of a well, regardless of how the well was completed.

F Attach separate letter of request if the information is to be held confidential. If confidential, only file one copy. Information on Side One will be of public record and Side Two will then be held confidential.

Applications must be made on dual completion, commingling, salt water disposal, injection and temporarily abandoned wells.

C Attach one copy only wireline logs (i.e. electrical log, sonic log, gamma ray neutron log, etc.). (Rules 82-2-105 & 82-2-125) KCC# (316) 263-3238.

LICENSE # 5171 EXPIRATION DATE 6/30/83

OPERATOR TXO PROD. CORP. API NO. 15-151-21,231-6000

ADDRESS 200 W. Douglas, Ste. 300 COUNTY Pratt

Wichita, KS 67202 FIELD Swisher

** CONTACT PERSON Harold R. Trapp PROD. FORMATION Not producing
PHONE 265-9441

PURCHASER Dry - no purchaser LEASE Peachey

ADDRESS see above WELL NO. #1

DRILLING FWA, Rig #32 WELL LOCATION C SW SE
CONTRACTOR 660 Ft. from South Line and

ADDRESS P.O. Box 970 1980 Ft. from East Line of
Yukon, OK 73099 the SE (Qtr.) SEC 35 TWP 28 SRGE 13 (W).

PLUGGING Same as above WELL PLAT (Office Use Only)

CONTRACTOR Same as above

TOTAL DEPTH 4815 PBD None

SPUD DATE 12-11-82 DATE COMPLETED Dry, 12-18-82

ELEV: GR 1924 DF Unknown KB 1935


DRILLED WITH (XXXXX) (ROTARY) (XXXX) TOOLS.

DOCKET NO. OF DISPOSAL OR REPRESSURING WELL BEING USED TO DISPOSE OF WATER FROM THIS LEASE No water

Amount of surface pipe set and cemented 8-5/8" @ 438' DV Tool Used? No

THIS AFFIDAVIT APPLIES TO: (Circle ONE) - Oil, Gas, Shut-in Gas, Dry, Disposal, Injection, Temporarily Abandoned, OWWO. Other _____

ALL REQUIREMENTS OF THE STATUTES, RULES AND REGULATIONS PROMULGATED TO REGULATE THE OIL AND GAS INDUSTRY HAVE BEEN FULLY COMPLIED WITH.

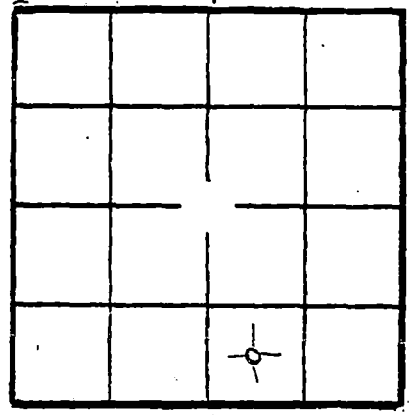

KCC _____
KGS _____
SWD/REP _____
PLG. _____


A F F I D A V I T

Harold R. Trapp, being of lawful age, hereby certifies that:

I am the Affiant, and I am familiar with the contents of the foregoing Affidavit. The statements and allegations contained therein are true and correct.

Harold R. Trapp
(Name)

SUBSCRIBED AND SWORN TO BEFORE ME this 21st day of December, 1982.

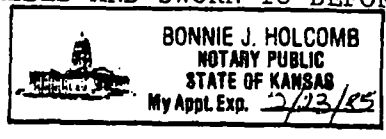

Bonnie J. Holcomb
(NOTARY PUBLIC)

MY COMMISSION EXPIRES: 12-23-85

RECEIVED
STATE COMMISSION
JAN 25 1983
REGISTRATION DIVISION
Wichita, Kansas

** The person who can be reached by phone regarding any questions concerning this information.