

This form shall be filed in duplicate with the Kansas Corporation Commission, 200 Colorado Derby Building, Wichita, Kansas 67202, within ten days after the completion of the well, regardless of how the well was completed.

Attach separate letter of request if the information is to be held confidential. If confidential, only file one copy. Information on side one will be of public record and side two will then be held confidential.

Circle one: Oil Gas, Dry, SWD, OWWO, Injection. Type and complete ALL sections. Applications must be filed for dual completion, commingling, SWD and injection, T.A.

Attach wireline logs (i.e. electrical log, sonic log, gamma ray neutron log, etc.). KCC # (316) 263-3238. (Rules 82-2-105 & 82-2-125)

OPERATOR Pickrell Drilling Company

API NO. 15-097-20,833-0000

ADDRESS 205 Litwin Building

COUNTY Kiowa

Wichita, Kansas 67202

FIELD Thatch

\*\*CONTACT PERSON Jack Gurley

PROD. FORMATION Mississippian

PHONE (316) 262-8427

LEASE Miller '00'

PURCHASER Koch Oil Company

WELL NO. 1

ADDRESS Box 2256

WELL LOCATION SE SE NW

Wichita, Kansas 67201

2310 Ft. from West Line and

DRILLING Pickrell Drilling Company

330 Ft. from South Line of

CONTRACTOR

ADDRESS 205 Litwin Building

the NW/4 SEC. 22 TWP. 29S RGE. 19W


Wichita, Kansas 67202

WELL PLAT

PLUGGING

CONTRACTOR

ADDRESS

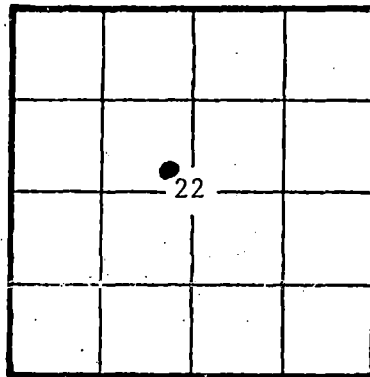

KCC \_\_\_\_\_  
KGS \_\_\_\_\_  
(Office Use)

TOTAL DEPTH 5200' PBD 5180' (Float)

SPUD DATE 10-19-81 DATE COMPLETED

ELEV: GR 2344' DF 2347' KB 2349'

DRILLED WITH (CABLE) (ROTARY) (AIR) TOOLS

Amount of surface pipe set and cemented 606' DV Tool Used? No

AFFIDAVIT

RECEIVED  
STATE CORPORATION COMMISSION  
8-26-1982  
AUG 26 1982

STATE OF Kansas, COUNTY OF Sedgwick

Jack Gurley OF LAWFUL AGE, BEING FIRST DULY SWORN

DEPOSES THAT HE IS Engineer (FOR) Pickrell Drilling Company

OPERATOR OF THE Miller '00' LEASE, AND IS DULY AUTHORIZED TO MAKE

THIS AFFIDAVIT FOR AND ON THE BEHALF OF SAID OPERATOR, THAT WELL NO. 1 ON SAID LEASE HAS BEEN COMPLETED AS OF THE 15th DAY OF February, 1982, AND THAT ALL INFORMATION ENTERED HEREIN WITH RESPECT TO SAID WELL IS TRUE AND CORRECT.

FURTHER AFFIANT SAITH NOT.

SUBSCRIBED AND SWORN BEFORE ME THIS 15th DAY OF February, 1982

(S) Jack Gurley  
February 15, 1982  
Sue A. Brownlee  
NOTARY PUBLIC Sue A. Brownlee

SUE A. BROWNLEE  
NOTARY PUBLIC  
STATE OF KANSAS  
MY COMMISSION EXPIRES: February 24, 1985  
Appt. Expires

\*\*The person who can be reached by phone regarding any questions concerning this information. Within 45 days of completion, a witnessed initial test by the Commission is required if the well produces more than 25 BOPD or is located in a Basic Order Pool.