


STATE OF KANSAS  
STATE CORPORATION COMMISSION

Form CP-4

Give All Information Completely  
Make Required Affidavit  
Mail or Deliver Report to:  
Conservation Division  
State Corporation Commission  
212 No. Market  
Wichita, Kansas

WELL PLUGGING RECORD

Kingman County. Sec. 34 Twp. 27S Rge. 7 (X) W (W)  
Location as "NE/CNW/SW" or footage from lines C-NW NE  
Lease Owner Mack Oil Company  
Lease Name Albert Well No. 1  
Office Address 812 Union Center, Wichita, Kansas  
Character of Well (completed as Oil, Gas or Dry Hole) Dry Hole  
Date well completed February 2 1968  
Application for plugging filed February 2 1968  
Application for plugging approved February 2 1968  
Plugging commenced February 4 1968  
Plugging completed February 4 1968  
Reason for abandonment of well or producing formation Dry Hole

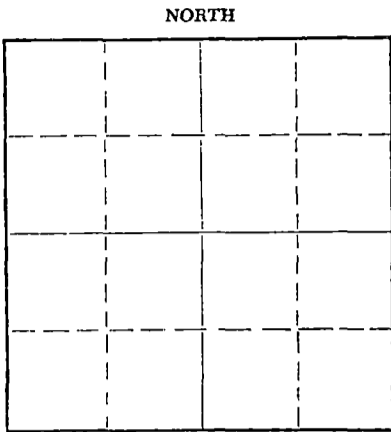

Locate well correctly on above Section Plat

If a producing well is abandoned, date of last production 19  
Was permission obtained from the Conservation Division or its agents before plugging was commenced? Yes

Name of Conservation Agent who supervised plugging of this well Archie V. Elving, Pratt, Kansas  
Producing formation Depth to top Bottom Total Depth of Well 4272 Feet  
Show depth and thickness of all water, oil and gas formations.

OIL, GAS OR WATER RECORDS

CASING RECORD

FORMATION	CONTENT	FROM	TO	SIZE	PUT IN	PULLED OUT

Describe in detail the manner in which the well was plugged, indicating where the mud fluid was placed and the method or methods used in introducing it into the hole. If cement or other plugs were used, state the character of same and depth placed, from feet to feet for each plug set.

Plugged with 45 Sacks Pozmix at 270'  
10 Sacks Pozmix at 40'  
5 Sacks Pozmix in Rat-hole.

RECEIVED  
STATE CORPORATION COMMISSION  
FEB 8 - 1968  
CONSERVATION DIVISION  
Wichita, Kansas

(If additional description is necessary, use BACK of this sheet)  
Name of Plugging Contractor Mack Oil Company  
Address P.O. Box 400, Duncan, Oklahoma

STATE OF KANSAS, COUNTY OF SEDGWICK, ss.  
Robert L. Harris (employee of owner) or (owner or operator) of the above-described well, being first duly sworn on oath, says: That I have knowledge of the facts, statements, and matters herein contained and the log of the above-described well as filed and that the same are true and correct. So help me God.  
(Signature) Robert L. Harris  
812 Union Center Bldg, Wichita, Kansas (Address)

SUBSCRIBED AND SWORN to before me this 6th day of February, 1968

My commission expires Sept. 28, 1968

Donna L. Podolak Notary Public.

MACK OIL COMPANY  
Duncan, Oklahoma

DRILLERS WELL LOG

# 1 Albert

Commenced R.D: 1-25-68  
Completed R.D.: 2- 3-68  
Drillers Total Depth: 4274

C-NW-NE Section 34-27S-7W  
Kingman County, Kansas  
Elevation: 1583 KB  
Initial Production: Dry  
Contractor: Mack Oil Co.

<u>STRATA</u>	<u>DEPTH</u>
Sand	0- 40
Shale & Shells	40- 285
Shale & Sand	285- 815
Shale & Shells	815-1100
Shale & Lime	1100-1325
Shale & Shells	1325-1520
Lime	1520-1572
Lime & Shale	1572-1903
Shale & Lime	1903-2414
Lime	2414-2717
Lime & Shale	2717-2909
Lime	2909-3345
Lime & Shale	3345-3445
Lime	3445-4274

RECEIVED  
STATE CORPORATION COMMISSION  
FEB 8 - 1968  
CONSERVATION DIVISION  
Wichita, Kansas

I hereby certify that the above is a true and correct log of said well as reflected by the daily drilling reports.

MACK OIL COMPANY

By Robert L. Harris  
Robert L. Harris

Signed and sworn to in my presence this 6th day of February, 1968,  
by Robert L. Harris, representative of Mack Oil Company.

Donna L. Podoljak  
Donna L. Podoljak-Notary Public

My commission expires  
September 28, 1968.

