


STATE OF KANSAS  
STATE CORPORATION COMMISSION

WELL PLUGGING RECORD

Give All Information Completely  
Make Required Affidavit  
Mail or Deliver Report to:  
Conservation Division  
State Corporation Commission  
211 No. Broadway  
Wichita, Kansas

Kingman County, Sec. 20 Twp. 27S Rge. (E) 7 (W)  
Location as "NE/CNW%SW%" or footage from lines SE SE SE  
Lease Owner Tennessee Gas Transmission Company  
Lease Name Adrian W. Wallace Well No. 1  
Office Address P. O. Box 513 - Chase, Kansas  
Character of Well (completed as Oil, Gas or Dry Hole) Dry Hole  
Date well completed May 11 19 57  
Application for plugging filed May 24 19 57  
Application for plugging approved Oral May 11 19 57  
Plugging commenced May 11 19 57  
Plugging completed May 11 19 57  
Reason for abandonment of well or producing formation \_\_\_\_\_

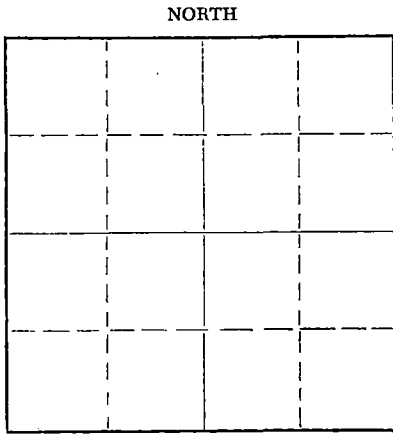

Locate well correctly on above  
Section Plat

If a producing well is abandoned, date of last production \_\_\_\_\_ 19\_\_\_\_  
Was permission obtained from the Conservation Division or its agents before plugging was commenced? Yes

Name of Conservation Agent who supervised plugging of this well M. A. Rives  
Producing formation \_\_\_\_\_ Depth to top \_\_\_\_\_ Bottom \_\_\_\_\_ Total Depth of Well 4395 Feet  
Show depth and thickness of all water, oil and gas formations.

OIL, GAS OR WATER RECORDS

CASING RECORD

FORMATION	CONTENT	FROM	TO	SIZE	PUT IN	PULLED OUT
				8-5/8"	244	None

Describe in detail the manner in which the well was plugged, indicating where the mud fluid was placed and the method or methods used in introducing it into the hole. If cement or other plugs were used, state the character of same and depth placed, from \_\_\_\_\_ feet to \_\_\_\_\_ feet for each plug set.

Filled hole with heavy mud to 245'

Set bottom plug @ 245' w/ 1/2 sack hulls on plug

Cemented w/20 sacks wet cement,

Mud to 35'

Set top plug @ 35' w/ 1/2 sack hulls on top of plug.

Cemented w/10 sacks cement to surface

All cement through drill pipe.

(If additional description is necessary, use BACK of this sheet)

Name of Plugging Contractor Virginia Drilling Company  
Address Wichita, Kansas

STATE OF Kansas, COUNTY OF Rice Sedgwick, ss.  
Glen E. Armour (employee of owner) or (owner/operator) of the above-described well, being first duly sworn on oath, says: That I have knowledge of the facts, statements, and matters herein contained and the log of the above-described well as filed and that the same are true and correct. So help me God.

(Signature) Glen E. Armour

SUBSCRIBED AND SWORN to before me this 27 day of May, 1957

(Address) Seward S. Greider, Notary Public.

My commission expires Jan. 31, 1961

PLUGGING  
FILE SEC 20 T. 27 7W  
300K PAGE 12 LINE 18

STATE CORPORATION COMMISSION  
MAY 23 1957  
CONSERVATION DIVISION  
Wichita, Kansas

5-28-1957

200 Chase  
200 Houston  
100 Wichita  
100 Denver

Adrian W. Wallace # 1 - SE SE SE Section 20-27-7 Kingman County, Kansas  
 Company - Tennessee Gas Transmission Company  
 Contractor - Virginia Drilling Co., Inc.  
 Commenced - April 20, 1957  
 Completed - May 11, 1957  
 Elevation - Est. 1608 DF  
 Total Depth - 4395  
 8 5/8" casing set at 245 ft.  
 D.H.

FORMATION	DEPTH	
Surface clay-sand-redbed- & shale	0- 210	
Red bed & shells	210- 595	
Anhydrite	595- 605	
Grey shale & shells	605- 715	
Shale-shells	715- 920	
Salt	920- 955	
Shale-shells	955-1040	
Gyp	1040-1150	
Gyp-shale	1150-1255	
Shale-lime	1255-1290	
Lime broken	1290-1355	
Shale-lime	1355-1640	
Lime Ft. Riley	1640-1740	
Lime-shells-shale	1740-1845	
Lime-shale	1845-2330	
Lime	2330-2460	
Shale-lime	2460-2515	
Lime	2515-2610	
Lime-shale	2610-2665	
Shale-sandy	2665-2710	
Lime	2710-2835	
Lime-shale	2835-2935	
Lime	2935-3070	
Shale-sandy lime	3070-3198	
Lime-shale	3198-3275	
Lime	3275-3440	
Lime-chert	3440-3470	
Lime	3470-3516	
Lime-shale	3516-3583	
Lime	3583-3700	
Shale-lime-chert	3700-3740	
Lime	3740-3787	
Lime-shale	3787-3900	
Lime-chert	3900-3915	
Shale-lime	3915-3945	
Mississippi lime	3945-3956	
Mississippi chat	3956-4039	
Lime-shale	4039-4055	
Lime-chert-shale	4055-4082	
Lime-shale	4082-4258	
Lime	4258-4263	
Viola	4263-4278	
Lime-shale	4278-4282	
Sand	4282-4318	
Sand-shale	4318-4348	
Shale-lime	4348-4390	
Lime	4390-4395 T. D.	

- TOPS:
- 2998 - Heebner
  - 3025 - Toronto
  - 3230 - Brown lime
  - 3241 - Lansing
  - 3945 - Mississippi
  - 4254 - Viola
  - 4281 - Simpson
  - 4370 - Arbuckle

*W. A. Murphy*

Subscribed and sworn to before me, a Notary Public,  
 this 20th day of May, 1957

*Walter D. Smith*  
 Notary Public

My commission expires: 2-5-61

RECORDED  
 STATE CORP. DIVISION

MAY 20 1957  
 CORP. DIVISION

PLUGGING  
 FILE SEC. 20 T. 27 R. 7W  
 BOOK PAGE 12 L. 18