


STATE OF KANSAS
STATE CORPORATION COMMISSION

WELL PLUGGING RECORD

Give All Information Completely
Make Required Affidavit
Mail or Deliver Report to:
Conservation Division
State Corporation Commission
800 Bittling Building
Wichita, Kansas

Kingman County, Sec. 16 Twp. 27S Rge. 7 (E) 7 (W)
Location as "NE/CNW%SW%" or footage from lines NE/4 NW/4 NE/4
Lease Owner Heathman-Seeligson Drilling Co.
Lease Name WOOLDRIDGE "A" Well No. 2
Office Address 1015 East Second, Wichita 7, Kansas
Character of Well (completed as Oil, Gas or Dry Hole) oil well
Date well completed February 13 1955
Application for plugging filed November 20 1955
Application for plugging approved " 1955
Plugging commenced " 1955
Plugging completed " 1955
Reason for abandonment of well or producing formation well went to water on original completion - were unable to obtain commercial oil or gas production on workover
If a producing well is abandoned, date of last production July 30 1955
Was permission obtained from the Conservation Division or its agents before plugging was commenced? yes

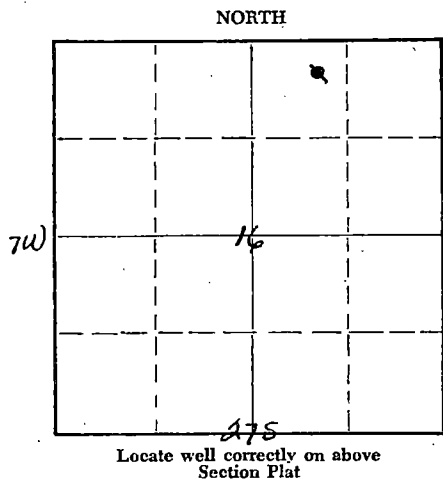

Name of Conservation Agent who supervised plugging of this well M. A. Rives, Box 2, Pratt, Kansas
Producing formation Mississippian Chert Depth to top 3800 Bottom 3847 Total Depth of Well 3847 Feet
Show depth and thickness of all water, oil and gas formations.

OIL, GAS OR WATER RECORDS

CASING RECORD

FORMATION	CONTENT	FROM	TO	SIZE	PUT IN	PULLED OUT
Mississippian Chert	gas & oil Cut mud	3817	3822	8-5/8"	182'	none
	gas and oil	3822	3827	cemented	w/100 sax.	
	" " "	3827	3832			
	" " "	3832	3837	5-1/2" OD	3847'	
	" " "	3837	3842	cemented	w/100 sacks.	
	oil and gas cut mud	3842	3847			

Describe in detail the manner in which the well was plugged, indicating where the mud fluid was placed and the method or methods used in introducing it into the hole. If cement or other plugs were used, state the character of same and depth placed, from 3847 feet to Surface feet for each plug set.

Well was plugged back with cement plug, and perforated between 3829 to 3826, and squeezed off with 30 sacks of cement under 3000 pound pressure. At time of pulling pipe bottom of hole was found to be 3810. Following pulling of pipe Halliburton pump trucks were called and pumped in twenty sacks of mud, followed by a plug with sixty sacks of cement pumped in above plug, and plug pumped down to 130 feet.

Plugging Complete

(If additional description is necessary, use BACK of this sheet)

Name of Plugging Contractor Barnes and Sons Pipe Drilling Co.
Address 1450 Maple, Russell, Kansas

STATE OF Kansas, COUNTY OF ~~Kingman~~ Russell, ss.
(employee of owner) or (owner or operator) of the above-described well, being first duly sworn on oath, says: That I have knowledge of the facts, statements, and matters herein contained and the log of the above-described well as filed and that the same are true and correct. So help me God. BARNES AND SONS PIPE DRILLING CO.

(Signature) By: J. R. Barnes
1450 Maple, Russell, Kansas (Address)

SUBSCRIBED AND SWORN TO before me this 21st day of December, 1955

My commission expires May 3, 1958

Notary Public. [Signature]

PLUGGING
FILE REC-16 T 27 R 7W
BOOK PAGE 25 LINE 41

1-11-1956

ROTARY DRILLING LOG

OPERATOR: Heathman-Seeligson Drlg. Co.
 Woodridge "A" #2
 NE NW 1/4 Sec. 16-27-7W
 Kingman County, Kansas

CONTRACTOR: Prime Drilling Co.
 COMM: 1-15-55
 COMP: 2-1-55

FORMATION

REMARKS

Sand	30
Red Bed, Shells & Shale	182
Red Bed & Shale	275
Shale & Shells	295
Anhydrite	1025
Shale & Shells	1070
Lime & Shale	1295
Lime	1535
Shale & Lime	1730
Lime with Shale breaks	1865
Shale & Lime streaks	2030
Shale & Lime	2605
Lime with Shale Breaks	2620
Lime	2955
Lime & Shale	3097
Lime	3730
Shale & Lime Conglomerate	3780
Lime	3798
Core #1	3822
Core #2	3827
Core #3	3832
Core #4	3837
Core #5	3842
Core #6	3847
Rotary Total Depth	3847

Ran 182' of 8-5/8" surface casing cemented with 180 sacks cement and 2% C.C.

Set 5-1/2" casing at 3846' cemented with 100 sacks nozmix.

We certify that the above log is true and correct to the best of our knowledge and belief.

PRIME DRILLING COMPANY

R. R. McNiccol
 R. R. McNiccol

RECEIVED
 STATE CORPORATION COMMISSION

JAN 14 1956

CONSERVATION DIVISION
 Wichita, Kansas

PLUGGING
 FILE SEC 16-27-7W
 BOOK PAGE 25 LINE 41