


STATE OF KANSAS
STATE CORPORATION COMMISSION

Give All Information Completely
Make Required Affidavit
Mail or Deliver Report to:
Conservation Division
State Corporation Commission
800 Bitting Building
Wichita, Kansas

WELL PLUGGING RECORD

Kingman County. Sec. 15 Twp. 27 Rge. 7 (E) (W)
Location as "NE/CNW/SW" or footage from lines SE NW NE/4
Lease Owner L. W. Schmidt
Lease Name Bowyer Well No. 1
Office Address Lamar, Colorado
Character of Well (completed as Oil, Gas or Dry Hole) dry hole
Date well completed 5-11-56 19
Application for plugging filed 5-11-56 19
Application for plugging approved 5-11-56 19
Plugging commenced 5-11-56 19
Plugging completed 5-11-56 19
Reason for abandonment of well or producing formation _____

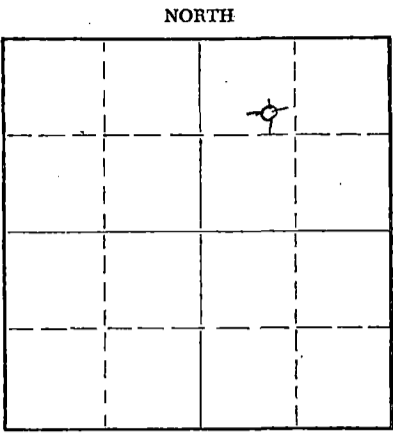

Locate well correctly on above
Section Plat

If a producing well is abandoned, date of last production _____ 19
Was permission obtained from the Conservation Division or its agents before plugging was commenced? yes

Name of Conservation Agent who supervised plugging of this well M. A. Rives, Ex 8 - Pratt, Kansas
Producing formation _____ Depth to top _____ Bottom _____ Total Depth of Well 4285 Feet
Show depth and thickness of all water, oil and gas formations.

OIL, GAS OR WATER RECORDS

CASING RECORD

FORMATION	CONTENT	FROM	TO	SIZE	PUT IN	PULLED OUT
		0	213	8 5/8"	214.41	none

Describe in detail the manner in which the well was plugged, indicating where the mud fluid was placed and the method or methods used in introducing it into the hole. If cement or other plugs were used, state the character of same and depth placed, from _____ feet to _____ feet for each plug set.

Mudded to 210 ft - set plug w/ 20 sx cement & 1/4 sx hulls

Mudded to 35 ft - set plug w/ 10 sx cement & 1/4 sx hulls.

(If additional description is necessary, use BACK of this sheet)

Name of Plugging Contractor Virginia Drilling Co Inc.
Address 701 Brown Bldg. - Wichita 2, Kansas

STATE OF Kansas, COUNTY OF Sedgwick, ss.
S. A. Murphy (employee of owner) or (owner or operator) of the above-described well, being first duly sworn on oath, says: That I have knowledge of the facts, statements, and matters herein contained and the log of the above-described well as filed and that the same are true and correct. So help me God.

(Signature) [Signature]
701 Brown Bldg. Wichita 2, Kansas
(Address)

SUBSCRIBED AND SWORN to before me this 15th day of May, 1956

My commission expires February 5, 1957

[Signature]
Notary Public.

PLUGGING
FILE SEC. 15 T. 27 R. 7W
BOOK PAGE 61 LINE 7

MAY 17 1956
CONSERVATION DIVISION
Wichita, Kansas

BOWYER # 1 - SE NW NE/4 Section 15-27-7 Kingman County, Kansas
 Company - L. W. Schmidt
 Contractor - Virginia Drilling Co Inc.
 Commenced - April 23, 1956
 Completed - May 11, 1956
 Elevation - 1520 DF
 Total Depth - 4285 8 5/8" set at 213 ft.

FORMATION	DEPTH	
Sand-clay-shale-shells	0-185	
Shale-shells	185-213	
Shale	213-250	
Red bed	250-295	
Shale-shells	295-655	
Salt-shale-shells	655-895	
Shale-shells	895-1025	TOPS:
shale-lime	1025-1485	
Broken lime	1485-1575	3124 - Kansas City
Lime-shale	1575-1945	3815 - Mississippi
Shale-shells	1945-2165	4134 - Misener
Shale-lime	2165-2755	4136 - Viola
Lime	2755-2880	4148 - Simpson
Shale-sandy lime	2880-3095	4251 - Arbuckle
Lime	3095-3570	
Lime-shale	3570-3815	
Lime	3815-3844	
Lime-chert	3844-3965	
Lime-shale	3965-3990	
Shale	3990-4070	
Shale-lime	4070-4135	
Lime	4135-4140	
Lime-sand	4140-4160	
Simpson shale-sand	4160-4215	
Simpson shale	4215-4255	
Lime	4255-4285 T. D.	

Murlee Hawkins
 Murlee Hawkins

Subscribed and sworn to before me, a Notary Public,
 this 16th day of May, 1956.

Inez M. Underwood
 Notary Public

My commission expires: March 15, 1958.

PLUGGING
 FILE SEC 15 T 27 R 7W
 BOOK PAGE 61 LINE 7