

STATE OF KANSAS
STATE CORPORATION COMMISSION

Give All Information Completely
Make Required Affidavit
Mail or Deliver Report to:
Conservation Division
State Corporation Commission
800 Bittling Building
Wichita, Kansas

WELL PLUGGING RECORD

NORTH

#1.			
	27		

Locate well correctly on above
Section Plat

Butler County. Sec. 27 Twp. 27 Rge. 6 (E) (W)
Location as "NE/CNW/SW" or footage from lines. 330'S 330'W of N¹/₄ Corner
Lease Owner Cities Service Oil Company
Lease Name Lampe Well No. 1
Office Address Bartlesville, Oklahoma
Character of Well (completed as Oil, Gas or Dry Hole) Dry Hole
Date well completed 9-13-1953
Application for plugging filed 9-17-1953
Application for plugging approved 9-16-1953
Plugging commenced 9-13-1953
Plugging completed 9-13-1953
Reason for abandonment of well or producing formation Dry Hole

If a producing well is abandoned, date of last production 19
Was permission obtained from the Conservation Division or its agents before plugging was commenced? Yes

Name of Conservation Agent who supervised plugging of this well
Producing formation Depth to top Bottom Total Depth of Well 4351 Feet
Show depth and thickness of all water, oil and gas formations.

OIL, GAS OR WATER RECORDS				CASING RECORD		
FORMATION	CONTENT	FROM	TO	SIZE	PUT IN	PULLED OUT
				8 5/8"	214'	Left in

Describe in detail the manner in which the well was plugged, indicating where the mud fluid was placed and the method or methods used in introducing it into the hole. If cement or other plugs were used, state the character of same and depth placed, from feet to feet for each plug set.

Mud to 210' and wood plug at 210', fill with gravel to 205' and cemented with 15 sacks of cement filled to 157'. Mud to 15' with top plug and cemented with 5 sacks of cement. Fill to surface.


(If additional description is necessary, use BACK of this sheet)
Name of Plugging Contractor Rine Drilling Company
Address 320 Central Bldg., Wichita, Kansas.

STATE OF Kansas, COUNTY OF Butler, ss.
(employee of owner) or (owner or operator) of the above-described well, being first duly sworn on oath, says: That I have knowledge of the facts, statements, and matters herein contained and the log of the above-described well as filed and that the same are true and correct. So help me God.

(Signature) [Signature]
Bellevue, Kansas
(Address)

SUBSCRIBED AND SWORN TO before me this 21st day of September 1953
[Signature]
Notary Public.

My commission expires June 6, 1955

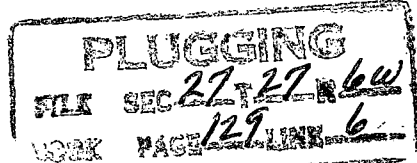

24-7368-S 3-53-20M

9-22-1953

Cities Service Oil Company

Sec. 27-27-6W
Kingman County, Kansas

Lampe #1

Drlg. Comm: 8-26-53
Drlg. Comp: 9-13-53
Drld. By: Rine Drilling Co.Loc: 330'S, 330'W of N₂ Corner
Elev:
Note: All measurements taken from R.T.B.

T.D. 4351'

I.P: D & A.

Casing Record:
3 5/8" set at 214' with 125 sax.

<u>Formation Record:</u>	<u>Depth:</u>
Shale O-	270
Anhydrite or iron	272
Rock Blue Shale & shells	640
Shale & shells	955
Anhydrite	985
Shale & shells	1260
Shale	1300
Streak lime	1380
Shale & lime	1435
Lime & shale	1610
Shale & shells	1850
Shale & lime	2030
Lime & shale	2120
Shale & lime	2250
Lime & shale	2405
Shale, lime & sand	2485
Lime & shale	2750
Shale & lime	2875
Lime & shale	2896
Sand	2970
Lime & shale	3070
Lime	3400
Lime & shale	3455
Lime	3655
Lime & shale	3750
Lime, shale & chert	3800
Chert	3805
Lime & chert	3855
Lime & shale	3940
Chert & shale	3974
Cherty lime	4014
Lime	4035
Lime & chert	4055
Cherty lime & lime	4110
Lime	4188
Lime & sand	4215
Lime & sandy shale	4256
Lime & sand	4264
Lime	4265
Sandy lime & shale	4285
Lime & shale	4313
Lime & chert	4351 T.D.

RECEIVED
STATE OF KANSAS COMMISSION
SEP 19 1953
CONSERVATION DIVISION
Topeka, Kansas

PLUGGING
FILE SEC 27 T 27 R 6W
BOOK PAGE 129 LINE 6