

STATE OF KANSAS
STATE CORPORATION COMMISSION

Form CP-4


WELL PLUGGING RECORD

Give All Information Completely
Make Required Affidavit
Mail or Deliver Report to:
Conservation Division
State Corporation Commission
212 No. Market
Wichita, Kansas

Sedgwick County, Sec. 31 Twp. 27 Rge. 4 (E) W (W)

Location as "NE/CNW%SW%" or footage from lines SE SE NW
Lease Owner The Shallow Water Refining Company
Lease Name Bartholomew Unit, Tract 9 Well No. 5
Office Address Wichita, Kansas
Character of Well (completed as Oil, Gas or Dry Hole)
Date well completed 19
Application for plugging filed 19
Application for plugging approved 19
Plugging commenced 3-12-66 19
Plugging completed 3-23-66 19
Reason for abandonment of well or producing formation Depleted.

NORTH

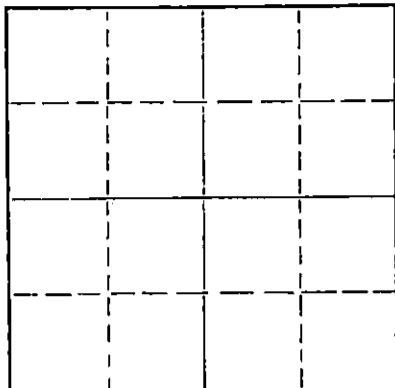

Locate well correctly on above
Section Plat

If a producing well is abandoned, date of last production 19
Was permission obtained from the Conservation Division or its agents before plugging was commenced? yes

Name of Conservation Agent who supervised plugging of this well Paul Turpin
Producing formation _____ Depth to top _____ Bottom _____ Total Depth of Well 3732 Feet
Show depth and thickness of all water, oil and gas formations.

OIL, GAS OR WATER RECORDS

CASING RECORD

FORMATION	CONTENT	FROM	TO	SIZE	PUT IN	PULLED OUT
				8-5/8"	200'	None
				5-1/2"	3727'	2304'

Describe in detail the manner in which the well was plugged, indicating where the mud fluid was placed and the method or methods used in introducing it into the hole. If cement or other plugs were used, state the character of same and depth placed, from _____ feet to _____ feet for each plug set.

Checked hole, sanded hole to 3710' and dumped 5 sacks of cement @ 3710' with dump bailer. Pulled 5 1/2" casing, set rock bridge @ 200' and dumped 20 sacks of cement. Mudded hole to 30' and ran 10 sacks of cement to base of cellar.

RECEIVED
STATE CORPORATION COMMISSION

MAR 29 1966

3-29-66

CONSERVATION DIVISION
WICHITA, KANSAS

PLUGGING COMPLETE.

Name of Plugging Contractor KNIGHT CASING PULLING COMPANY
Address CHASE, KANSAS

STATE OF KANSAS, COUNTY OF RICE, ss.
Noel J. Knight (employee of owner) or (owner/operator) of the above-described well, being first duly sworn on oath, says: That I have knowledge of the facts, statements, and matters herein contained and the log of the above-described well as filed and that the same are true and correct. So help me God.

(Signature) Noel J. Knight
Chase, Kansas
(Address)

SUBSCRIBED AND SWORN TO before me this 25th day of March, 1966

My commission expires May 20, 1968

Milton J. Holm
Notary Public.

XERO COPY

XERO COPY

XERO COPY

XERO COPY

#9-5

WELL LOG BUREAU KANSAS GEOLOGICAL SOCIETY


shallow water 508 E. Murdock Wichita, Kansas
Bartholomew Unit Tract #9 Well #5

Company - J. M. HUBER CORPORATION
Farm - Loronz No. 5

SEC. 31 T. 27 R. 4W
SE SE NW

Total Depth. 3732
Comm. 7-10-50 Corp. 7-22-50
Shot or Treated.
Contractor - Fabco Drlg. Inc.
Issued. 9-2-50

County. Sedgwick
KANSAS

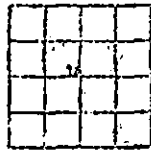

CASING:
8 5/8" 200' com. w/135 sx
5 1/2" 3732' com. w/75 sx

Elevation. 1405

Production. 1775 bbls.

Figures Indicate Bottom of Formations.

sand & shale	200
shale & shells	430
shale & salt	750
shale & lime	835
limo, shale & salt	1010
limo	1275
shale & limo	1290
shale	1310
limo & shale	1440
shale	2805
limo	2890
shale & limo	3435
shale	3651
shale & limo	3732
Total depth	

Tops:	
Brown limo	2836
Lansing	2867
Mississippi	3390
Dolomite	3727

RECEIVED
STATE CORPORATION COMMISSION

FEB 10 1966

CONSERVATION DIVISION
Wichita, Kansas