


STATE OF KANSAS  
STATE CORPORATION COMMISSION

Form CP-4

WELL PLUGGING RECORD

Give All Information Completely  
Make Required Affidavit  
Mail or Deliver Report to:  
Conservation Division  
State Corporation Commission  
212 No. Market  
Wichita, Kansas

NORTH

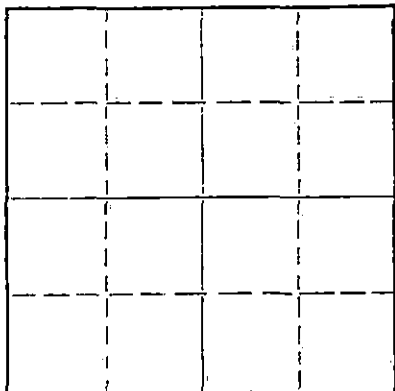

Locate well correctly on above  
Section Plat

Location as "NE/CNW/SW" or footage from lines Kingman County. Sec. 29 Twp. 27S Rge. 6  (E)  (W) West

Lease Owner MACK OIL CO.  
Lease Name Wolf Well No. 1  
Office Address 812 Union Center Bldg., Wichita, Kansas 67202  
Character of Well (completed as Oil, Gas or Dry Hole) Dry Hole  
Date well completed September 20 19 66  
Application for plugging filed September 21 19 66  
Application for plugging approved September 21 19 66  
Plugging commenced September 21 19 66  
Plugging completed September 21 19 66  
Reason for abandonment of well or producing formation Dry

If a producing well is abandoned, date of last production \_\_\_\_\_ 19\_\_\_\_  
Was permission obtained from the Conservation Division or its agents before plugging was commenced? Yes

Name of Conservation Agent who supervised plugging of this well Herman Justus, Nickerson, Kansas  
Producing formation None Depth to top \_\_\_\_\_ Bottom \_\_\_\_\_ Total Depth of Well 4294 Feet  
Show depth and thickness of all water, oil and gas formations.

OIL, GAS OR WATER RECORDS

CASING RECORD

FORMATION	CONTENT	FROM	TO	SIZE	PUT IN	PULLED OUT

Describe in detail the manner in which the well was plugged, indicating where the mud fluid was placed and the method or methods used in introducing it into the hole. If cement or other plugs were used, state the character of same and depth placed, from \_\_\_\_\_ feet to \_\_\_\_\_ feet for each plug set.  
Plugged with 30 sax common cement @ 235'  
25 sax common cement @ 50'  
5 sax common cement @ rathole  
Plug down @ 12:30 p.m., September 21, 1966

RECEIVED  
STATE CORPORATION COMMISSION  
SEP 23 1966

9-23-66  
CONSERVATION DIVISION  
Wichita, Kansas

(If additional description is necessary, use BACK of this sheet)

Name of Plugging Contractor MACK OIL CO.  
Address P. O. Box 400, Duncan, Oklahoma 73533

STATE OF KANSAS COUNTY OF SEDGWICK, ss.  
Robert L. Harris (employee of owner) or (owner or operator) of the above-described well, being first duly sworn on oath, says: That I have knowledge of the facts, statements, and matters herein contained and the log of the above-described well as filed and that the same are true and correct. So help me God.

(Signature) Robert L. Harris

812 Union Center Bldg., Wichita, Kansas  
(Address)

SUBSCRIBED AND SWORN TO before me this 21st day of September, 1966

Elizabeth F. Nice  
Elizabeth F. Nice Notary Public.

My commission expires September 21, 1968

MACK OIL COMPANY  
Duncan, Oklahoma

DRILLERS WELL LOG

#1 Wolf

C NE SW - Section 29-27S-6W  
Kingman County, Kansas  
Elevation: 1566' Kelly Bushing  
Initial Production: Dry  
Contractor: Mack Oil Company

Commenced R. D.: 9-11-66  
Completed R. D.: 9-20-66  
Rotary Total Depth: 4294'

<u>STRATA</u>	<u>DEPTH</u>
Sand	0 - 40'
Red Bed	40 - 240
Shale & Sand	240 - 1000
Shale & Shells	1000 - 1404
Lime	1404 - 1910
Lime & Shale	1910 - 2418
Lime	2418 - 2730
Lime & Shale	2730 - 2909
Sand & Lime	2909 - 3194
Lime	3194 - 3720
Shale & Lime	3720 - 3903
Chert	3903 - 3950
Chert & Lime	3950 - 3984
Lime	3984 - 4294'

RECEIVED  
STATE CORPORATION COMMISSION  
SEP 23 1966  
CONSERVATION DIVISION  
WENNA, KANSAS

I hereby certify that the above is a true and correct log of said well as reflected by the daily drilling reports.

MACK OIL COMPANY

By Robert L. Harris  
Robert L. Harris

Signed and sworn to in my presence this 21st day of September, 1966, by Robert L. Harris, representative of Mack Oil Company.

Elizabeth F. Nice  
Elizabeth F. Nice, Notary Public

My Commission Expires September 21, 1968