


STATE OF KANSAS  
STATE CORPORATION COMMISSION

WELL PLUGGING RECORD

Give All Information Completely  
Make Required Affidavit  
Mail or Deliver Report to:  
Conservation Division  
State Corporation Commission  
212 North Market, Insurance Bldg.  
Wichita, Kansas

Kingman County, Sec. 21 Twp. 27S Rge. 6W (W)

NORTH

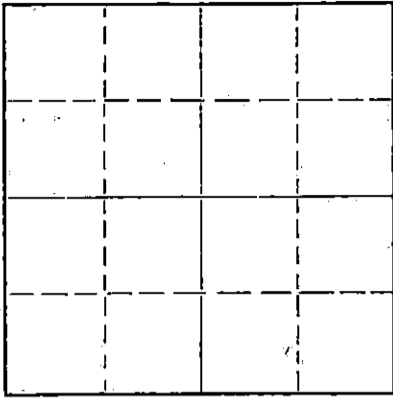

Locate well correctly on above  
Section Plat

Location as "NE/CNW/SW" or footage from lines C NE NW  
Lease Owner Kenneth Rupp  
Lease Name McCurdy Well No. 1  
Office Address 522 Union Center, Wichita, Kansas  
Character of Well (completed as Oil, Gas or Dry Hole) D & A  
Date well completed March 3, 19 61  
Application for plugging filed March 3, 19 61  
Application for plugging approved March 3, 19 61  
Plugging commenced March 3, 19 61  
Plugging completed March 3, 19 61  
Reason for abandonment of well or producing formation D & A

If a producing well is abandoned, date of last production 19  
Was permission obtained from the Conservation Division or its agents before plugging was commenced? Yes

Name of Conservation Agent who supervised plugging of this well Fred Hampel  
Producing formation \_\_\_\_\_ Depth to top \_\_\_\_\_ Bottom \_\_\_\_\_ Total Depth of Well \_\_\_\_\_ Feet  
Show depth and thickness of all water, oil and gas formations.

OIL, GAS OR WATER RECORDS

CASING RECORD

FORMATION	CONTENT	FROM	TO	SIZE	PUT IN	PULLED OUT
				8 5/8"	238'	-0-

Describe in detail the manner in which the well was plugged, indicating where the mud fluid was placed and the method or methods used in introducing it into the hole. If cement or other plugs were used, state the character of same and depth placed, from \_\_\_\_\_ feet to \_\_\_\_\_ feet for each plug set.

Filled hole with heavy mud  
to 235'. Set bottom plug with  
1/2 sx hulls and 15 sx cement.  
Set top plug with 1/2 sx hulls  
and 10 sx cement at 36'.  
Bridged rat hole with 2 sx cement.

RECEIVED  
STATE CORPORATION COMMISSION

MAR 9 1961

CONSERVATION DIVISION  
Wichita, Kansas

3-9-61

(If additional description is necessary, use BACK of this sheet)

Name of Plugging Contractor Red Tiger Drilling Company  
Address Box 173 - Russell, Kansas

STATE OF KANSAS COUNTY OF SEDGWICK, ss.  
George A. Angle (employee of owner) or (owner or operator) of the above-described well, being first duly sworn on oath, says: That I have knowledge of the facts, statements, and matters herein contained and the log of the above-described well as filed and that the same are true and correct. So help me God.

(Signature) George A. Angle  
590 Fourth Nat'l Bank Bldg., Wichita, Ks.  
(Address)

SUBSCRIBED AND SWORN TO before me this 6th day of March, 19 61

Mapine Head

Notary Public.

My commission expires 11-17-62

