


STATE OF KANSAS  
STATE CORPORATION COMMISSION

WELL PLUGGING RECORD

Give All Information Completely  
Make Required Affidavit  
Mail or Deliver Report to:  
Conservation Division  
State Corporation Commission  
800 Bitting Building  
Wichita, Kansas

NORTH

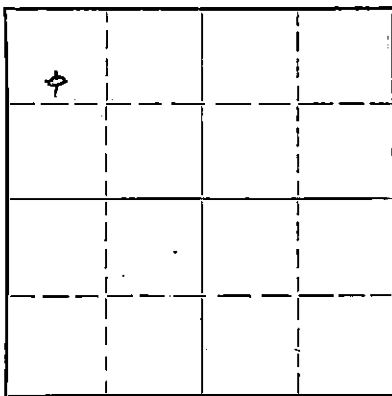

Locate well correctly on above  
Section Plat

Kingman County, Sec. 15 Twp. 27s Rge. 7 (E) (W)  
Location as "NE/CNW $\frac{1}{4}$ SW $\frac{1}{4}$ " or footage from lines Center S $\frac{1}{2}$  NW $\frac{1}{4}$  NW $\frac{1}{4}$   
Lease Owner Virginia Drilling Co., Inc.  
Lease Name Rayl Well No. 1  
Office Address 701 Brown Bldg., Wichita 2, Kansas  
Character of Well (completed as Oil, Gas or Dry Hole) dry hole  
Date well completed February 20 19 52  
Application for plugging filed February 20 19 52  
Application for plugging approved February 20 19 52  
Plugging commenced February 20 19 52  
Plugging completed February 20 19 52  
Reason for abandonment of well or producing formation dry

If a producing well is abandoned, date of last production 19  
Was permission obtained from the Conservation Division or its agents before plugging was commenced? YES

Name of Conservation Agent who supervised plugging of this well Ruel Durkee Box 597 McPherson, Kansas  
Producing formation Depth to top Bottom Total Depth of Well 3879 Feet  
Show depth and thickness of all water, oil and gas formations.

OIL, GAS OR WATER RECORDS

CASING RECORD

Formation	Content	From	To	Size	Put In	Pulled Out
				8-5/8	253	none
				5 1/2	3827	3410

Describe in detail the manner in which the well was plugged, indicating where the mud fluid was placed and the method or methods used in introducing it into the hole. If cement or other plugs were used, state the character of same and depth placed, from feet to feet for each plug set.

3820 to total depth-filled w/sand and chat  
3820 - plug set with 6 sacks cement  
3820 to 230 - filled hole with heavy mud  
230 - plug set with 15 sacks cement  
230-25' hole filled w/heavy mud  
25'-top plug set, cemented with 5 sacks cement

RECEIVED  
MAR 1 - 1952  
3-1-52

(If additional description is necessary, use BACK of this sheet)  
Name of Plugging Contractor Cecil Prather  
Address Great Bend, Kansas

STATE OF Kansas, COUNTY OF Sedgwick, ss.  
S. A. Murphy (employee of owner) or (owner or operator) of the above-described well,  
being first duly sworn on oath, says: That I have knowledge of the facts, statements, and matters herein contained and the log of the above-described well as filed and that the same are true and correct. So help me God.

(Signature) [Signature]  
701 Brown Bldg., Wichita 2, Kansas  
(Address)

SUBSCRIBED AND SWORN to before me this 28th day of February, 19 52  
[Signature] Notary Public.

My commission expires March 15, 1954

23-8390-3 6-51-20M

PLUGGING  
FILE SEC-16-T-27-R-20  
PAGE 107 LINE 3

Well: Rayl #1  
 Location: Center S/2 of NW/4 NW/4 Sec. 15-27s-7w, Kingman Co., Kansas  
 Company: Virginia Drilling Co., Inc. et al  
 Contractor: Virginia Drilling Co., Inc.  
 Commenced: January 8, 1952  
 Completed: February 20, 1952  
 Elevation: 1521 R. B.  
 Total Depth: 3879

FORMATION	DEPTH		
Red rock-shale	0-175	Set 8-5/8" csg @ 253'	
Shale-shells	175-1025	Set 3827" csg -5 1/2"	
Shale-lime	1025-1260		
Lime-brk.	1260-1420		
Lime	1420-1630		
Lime-shale	1630-2095		
Shale	2095-2225		
Shale-lime	2225-2800	TOPS:	
Lime	2800-2880	Lansing-Kansas City	3124
Lime-shale	2880-3135	Mississippian	3815
Lime	3135-3330		
Brk. Lime	3330-3395		
Lime-shale	3395-3815		
Mississippi	3815-3827		
Lime	3827-3879		

Now comes S. A. Murphy, who states that he is familiar with the drilling of oil and gas wells and knows of his own knowledge that the Rayl #1, located in the Center of the S/2 of the NW NW Sec, 15-27s-7w, Kingman County, Kansas, was drilled to a total depth of 3879 feet. Same was plugged and abandoned.

*S. A. Murphy*

Subscribed and sworn to before me this 28th day of February, 1952.

*J. M. Newman*

My commission expires March 15, 1954.

PLUGGING  
 SEC. 15-T-27-R-7-w  
 DATE 10/1/52