


STATE OF KANSAS
STATE CORPORATION COMMISSION

Give All Information Completely
Make Required Affidavit
Mail or Deliver Report to:
Conservation Division
State Corporation Commission
212 North Market, Insurance Bldg.
Wichita, Kansas

WELL PLUGGING RECORD

Kingman County, Sec. 28 Twp. 27 Rge. 5 (E) W (W)

Location as "NE/CNW/SW" or footage from lines C SE/4
Lease Owner Drillers Production Co., Inc.
Lease Name Hurn Well No. 2
Office Address Wichita, Kansas
Character of Well (completed as Oil, Gas or Dry Hole) _____
Date well completed _____ 19____
Application for plugging filed _____ 19____
Application for plugging approved _____ 19____
Plugging commenced 9-11-61 _____ 19____
Plugging completed 9-15-61 _____ 19____
Reason for abandonment of well or producing formation Depleted.

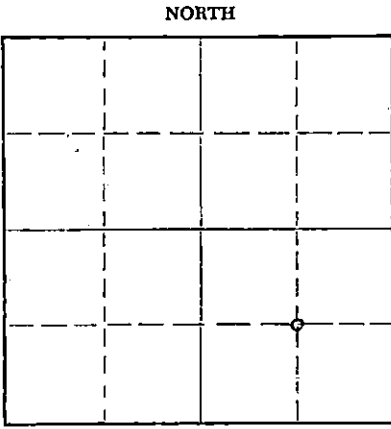

Locate well correctly on above Section Plat

If a producing well is abandoned, date of last production _____ 19____
Was permission obtained from the Conservation Division or its agents before plugging was commenced? yes

Name of Conservation Agent who supervised plugging of this well Fred Hample
Producing formation _____ Depth to top _____ Bottom _____ Total Depth of Well 3785 Feet
Show depth and thickness of all water, oil and gas formations.

OIL, GAS OR WATER RECORDS

CASING RECORD

FORMATION	CONTENT	FROM	TO	SIZE	PUT IN	PULLED OUT
				8-5/8"	256'	None
				4-1/2"	3780'	3336'

Describe in detail the manner in which the well was plugged, indicating where the mud fluid was placed and the method or methods used in introducing it into the hole. If cement or other plugs were used, state the character of same and depth placed, from _____ feet to _____ feet for each plug set.

Checked hole to 3785', ran sand to 3770' and dumped 5 sacks of cement @ 3770' with dump bailer. ~~XXXXXX~~
~~XXXX~~ Pulled 4 1/2" casing. Mudded hole to 250', set 10' rock bridge to 240' and ran 20 sacks of cement @ 240'. Mudded to 40', set 10' rock bridge to 30' and ran 10 sacks of cement to base of cellar.

PLUGGING COMPLETE.

RECEIVED
STATE CORPORATION COMMISSION

SEP 21 1961

CONSERVATION DIVISION
Wichita, Kansas

(If additional description is necessary, use BACK of this sheet)
Name of Plugging Contractor Knight Casing Pulling Company
Address Chase, Kansas

9-21-61

STATE OF Kansas, COUNTY OF Rice, ss.
Noel J. Knight (employee of owner) or (owner or operator) of the above-described well, being first duly sworn on oath, says: That I have knowledge of the facts, statements, and matters herein contained and the log of the above-described well as filed and that the same are true and correct. So help me God.

(Signature) Noel J. Knight
Chase, Kansas
(Address)

SUBSCRIBED AND SWORN TO before me this 18th day of September, 1961

Milton J. Volin
Notary Public.

My commission expires May 20, 1964



STENCILED

ORIGINAL

OCT 25 1960


WELL LOG BUREAU—KANSAS GEOLOGICAL SOCIETY
508 East Murdock, Wichita, Kansas

Company- DRILLERS PRODUCTION CO., INC.
Farm- Debba Hurn No. 2

SEC. 28 T. 27 R. 5W
C SE

Total Depth. 3796'
Comm. 7-7-60 Comp. 7-27-60
Shot or Treated.
Contractor. Gabbert-Jones Drlg. Co.
Issued. 10-15-60

County Kingman
KANSAS

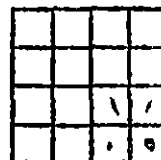

Elevation. 1470' KB

Production. 1,642,000 MCFGD

CASING:
8 5/8" 256' cem w/225 sx.
4 1/2" 3780' cem w/125 sx.

Figures Indicate Bottom of Formations.

sand & red bed	100
red bed	256
shale	750
Anhydrite	980
shale & shells	1030
lime & shale	3170
lime	3425
lime & shale	3755
lime	3787
chert	3796
Total Depth	

RECORDED
STATE COMMISSION
SEP 5 1961
CONSERVATION DIVISION
Wichita, Kansas

TOPS:	
Heebner	2716
Brown Lime	2957
Lansing	2984
Mississippi Chert	3777
Mississippi Dolomite	3787

DST 3779-87', 1 hr, G/2 1/2", 1350 MCFGD/8",
1390/15", 1350/30", 1330/45", 1330/60",
rec. 45' GCM, 20' muddy salt water.
I-FFP 185-199, I-FCIP/30" 1445-1402

DST 3788-96, 1 hr, G/20", TSTM thru 1",
rec. 100' oil specked mud. I-FFP 26-36,
I-FCIP/30" 1358-1370

Frac w/5000 gal Acid Petrfrac & 5000# sand