

SP

STATE OF KANSAS
STATE CORPORATION COMMISSION

Form CP-4


Give All Information Completely
Make Required Affidavit
Mail or Deliver Report to:
Conservation Division
State Corporation Commission
212 No. Market
Wichita, Kansas

WELL PLUGGING RECORD

Sedgwick County, Sec. 31 Twp. 27 Rge. 4 (E) W (W)

Location as "NE/CNW/SW" or footage from lines NE SE SW
Lease Owner Shallow Water Refining Company
Lease Name Bartholomew Unit, Tract 14 Well No. 7
Office Address Wichita, Kansas
Character of Well (completed as Oil, Gas or Dry Hole) _____
Date well completed _____ 19____
Application for plugging filed _____ 19____
Application for plugging approved _____ 19____
Plugging commenced 2-17-66 _____ 19____
Plugging completed 2-23-66 _____ 19____
Reason for abandonment of well or producing formation Depleted.

NORTH

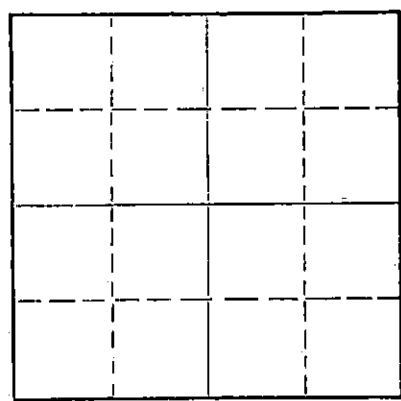

Locate well correctly on above.
Section Plat

If a producing well is abandoned, date of last production _____ 19____
Was permission obtained from the Conservation Division or its agents before plugging was commenced? yes

Name of Conservation Agent who supervised plugging of this well Paul Turpin
Producing formation _____ Depth to top _____ Bottom _____ Total Depth of Well 3756 Feet
Show depth and thickness of all water, oil and gas formations.

OIL, GAS OR WATER RECORDS

CASING RECORD

FORMATION	CONTENT	FROM	TO	SIZE	PUT IN	PULLED OUT
				8-5/8"	214'	None
				5-1/2"	3750'	3186'

Describe in detail the manner in which the well was plugged, indicating where the mud fluid was placed and the method or methods used in introducing it into the hole. If cement or other plugs were used, state the character of same and depth placed, from _____ feet to _____ feet for each plug set.

Checked hole to 3756', sanded hole to 3740' and dumped 5 sacks of cement @ 3740' with dump bailer. Pulled 5 1/2" casing, set rock bridge @ 200' and dumped 20 sacks of cement @ 200'. Mudded hole to 35' and ran 10 sacks of cement to base of cellar.

RECEIVED
STATE CORPORATION COMMISSION

MAR 7 1966

CONSERVATION DIVISION
Wichita, Kansas

3-7-66

PLUGGING COMPLETE.

(If additional description is necessary, use BACK of this sheet)

Name of Plugging Contractor KNIGHT CASING PULLING COMPANY
Address CHASE, KANSAS

STATE OF KANSAS, COUNTY OF RICE, ss.
Noel J. Knight (employee of owner) or ~~owner~~ of the above-described well, being first duly sworn on oath, says: That I have knowledge of the facts, statements, and matters herein contained and the log of the above-described well as filed and that the same are true and correct. So help me God.

(Signature) Paul J. Knight
Chase, Kansas
(Address)

SUBSCRIBED AND SWORN TO before me this 3rd day of March, 19 66

My commission expires May 20, 1968

Milton J. Volin
Notary Public.

KANSAS GEOLOGICAL BUREAU --- KANSAS GEOLOGICAL SOCIETY

508 EAST MURDOCK - WICHITA, KANSAS

COMPANY WESTGATE-GREENLAND OIL CO.

SEC. 31 T. 27 N. 4W

LOO. NE SE SW

FARM Davis

NO. 7

Shallow Water Rdy. Bartholomew Unit Grad 14 R

COPY

TOTAL DEPTH 3756

COMM. 7-8-50

COMP. 8-8-50


SHOT OR TREATED

CONTRACTOR Jackson Drilling Corp.

ISSUED 11-4-50

COUNTY Sedgwick

KANSAS

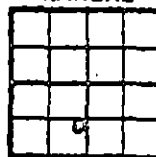

8 5/8" 214' ^{CASING} cem. w/135 SX.
5 1/2" 3750' cem. w/75 SX.

ELEVATION 1417

PRODUCTION Pot. 132 bbls.

FIGURES INDICATE BOTTOM OF FORMATIONS

surface clay	40
sand, shaled lime,	
shells	214
shale & shells	440
shale, salt	590
shale, lime, shells	785
lime, shale brks	875
shale, lime, shells	960
lime & shale	1460
shale, lime, shells	1620
shale & lime	2914
lime	3060
lime & shale	3144
lime	3183
lime & shale	3258
lime	3330
shale & lime	3720
lime	3756
Total Depth	

Tops:	
Brown lime	2851
Lansing	2890
Mississippi	3706
Dolo.	3748

1000 gals. Dowell Service.
Flowing 70 bbls. in 5 hr.

All measurements from top of derrick floor.

RECEIVED
STATE CORPORATION COMMISSION

FEB 10 1966

CONSERVATION DIVISION
Wichita, Kansas