

R

WELL PLUGGING RECORD

Give All Information Completely
Make Required Affidavit
Mail or Deliver Report to:
Conservation Division
State Corporation Commission
212 No. Market
Wichita, Kansas

Sedgwick County. Sec. 31 Twp. 27 Rge. 4 (E) (W)

Location as "NE/CNW/SW" or footage from lines. NE NE SW

Lease Owner Shallow Water Refining Company

Lease Name Bartholomew Tract 14, Well No. 5 W

Office Address Kansas City, Missouri

Character of Well (completed as Oil, Gas or Dry Hole)

Date well completed 19

Application for plugging filed 19

Application for plugging approved 19


Plugging commenced 12/13/68 19

Plugging completed 12/17/68 19

Reason for abandonment of well or producing formation depleted.

If a producing well is abandoned, date of last production 19

Was permission obtained from the Conservation Division or its agents before plugging was commenced? yes

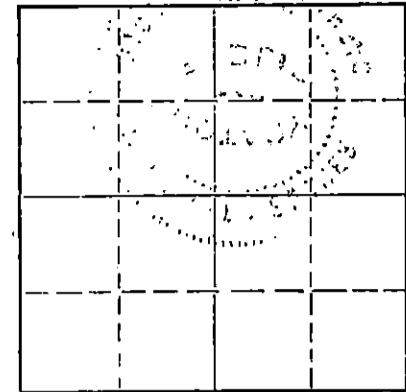

Locate well correctly on above Section Plot

Name of Conservation Agent who supervised plugging of this well Frank Dewey

Producing formation Depth to top Bottom Total Depth of Well 3742 Feet

Show depth and thickness of all water, oil and gas formations.

OIL, GAS OR WATER RECORDS

CASING RECORD

| FORMATION | CONTENT | FROM | TO | SIZE | PUT IN | PULLED OUT |
|-----------|---------|------|----|--------|--------|------------|
| | | | | 8-5/8 | 200' | none |
| | | | | 5 1/2" | 3735' | 1521' |
| | | | | | | |
| | | | | | | |
| | | | | | | |
| | | | | | | |
| | | | | | | |

Describe in detail the manner in which the well was plugged, indicating where the mud fluid was placed and the method or methods used in introducing it into the hole. If cement or other plugs were used, state the character of same and depth placed, from feet to feet for each plug set.

Checked hole, sanded back to 3720' and ran 5 sacks of cement. Loaded hole, hole didn't load, had perforation at 2278', pushed plug to 1800' and ran 50 gallons sand, had hole loaded again. Checked hole, shot pipe at 1521', worked pipe loose and pulled 49 joints. Set rock bridge at 200 to 180' and filled pipe with 4 yards ready mix. Tallied pipe.

PLUGGING COMPLETE.

RECEIVED
STATE CORPORATION COMMISSION
DEC 31 1968
CONSERVATION DIVISION
Wichita, Kansas

12-31-68

(If additional description is necessary, use BACK of this sheet)

Name of Plugging Contractor KNIGHT CASING PULLING CO., INC.
Address CHASE, KANSAS

STATE OF KANSAS, COUNTY OF RICE, ss. NOEL J. KNIGHT (employee of owner) or (owner or operator) of the above-described well, being first duly sworn on oath, says: That I have knowledge of the facts, statements, and matters herein contained and the log of the above-described well as filed and that the same are true and correct. So help me God.

(Signature) Noel J. Knight
Chase, Kansas (Address)

SUBSCRIBED AND SWORN TO before me this 23rd day of December, 1968

February 15, 1971

My commission expires

Margaret Melcher
Notary Public.

REC'D DEC 24 1968


copy
Tracy

Company - WESTGATE-GREENLAND OIL CO.
Farm - Davis No. 5 W.

SEC. 31 T. 27 S. 47
NE NE SW

Total Depth. 3742'
Com'n. 5-28-50 Comp. 6-17-50
Shot or Tested. Acid 1000 GALB.
Contractor. Jackson Drilling Corp.
Issued. 8-12-50

County. Sedgwick
KANSAS

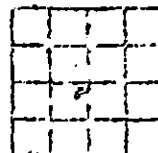

8 5/8" casing 200' cem w/135 BX.
5 1/2" 3735' cem w/ 75 BX.

Elevation. 1406 DF

Production. Pct. 400 bbls.

Figures Indicate Bottom of Formations.

| | |
|-----------------------|------|
| shale, shells | 440 |
| salt, shale, shells | 595 |
| shale, lime | 1045 |
| lime w/shale breaks | 1070 |
| lime, shale | 1600 |
| shale, w/lime streaks | 1740 |
| shale, shells | 1820 |
| shale, lime | 2135 |
| shale w/lime streaks | 2305 |
| lime, shale | 2560 |
| lime | 2680 |
| lime, shale | 2853 |
| lime | 2895 |
| lime, broken lime | 2970 |
| shale, broken lime | 3010 |
| lime | 3107 |
| lime, broken lime | 3183 |
| lime | 3295 |
| lime, shale | 3345 |
| shale | 3387 |
| lime, shale | 3690 |
| shale | 3694 |
| lime chert | 3742 |
| Total Depth | |

Tops:

| | |
|-------------|------|
| Lansing | 2881 |
| Mississippi | 3692 |
| Dolomite | 3732 |

RECEIVED
STATE CORPORATION COMMISSION
DEC 10 1968
CONSERVATION DIVISION
Wichita, Kansas