

9

STATE OF KANSAS  
STATE CORPORATION COMMISSION

Form CP-4

WELL PLUGGING RECORD

Give All Information Completely  
Make Required Affidavit  
Mail or Deliver Report to:  
Conservation Division  
State Corporation Commission  
212 No. Market  
Wichita, Kansas

Sedgwick County, Sec. 31 Twp. 27 Rge. 4 (E) W (W)

Location as "NE/CNW/SW" or footage from lines 1648' FWL, 990' FSL 8/2 SE/4

Lease Owner The Shallow Water Refining Company

Lease Name Bartholomew Unit, Tract 16 Well No. 3

Office Address Wichita, Kansas

Character of Well (completed as Oil, Gas or Dry Hole) \_\_\_\_\_

Date well completed \_\_\_\_\_ 19\_\_\_\_

Application for plugging filed \_\_\_\_\_ 19\_\_\_\_

Application for plugging approved \_\_\_\_\_ 19\_\_\_\_


Plugging commenced 3-11-66 \_\_\_\_\_ 19\_\_\_\_

Plugging completed: 3-16-66 \_\_\_\_\_ 19\_\_\_\_

Reason for abandonment of well or producing formation Depleted.

If a producing well is abandoned, date of last production \_\_\_\_\_ 19\_\_\_\_

Was permission obtained from the Conservation Division or its agents before plugging was commenced? Yes

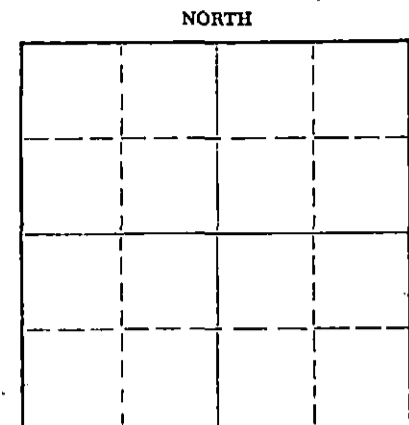

Locate well correctly on above Section Plat

Name of Conservation Agent who supervised plugging of this well Paul Turpin

Producing formation \_\_\_\_\_ Depth to top \_\_\_\_\_ Bottom \_\_\_\_\_ Total Depth of Well 3776 Feet

Show depth and thickness of all water, oil and gas formations.

OIL, GAS OR WATER RECORDS

CASING RECORD

FORMATION	CONTENT	FROM	TO	SIZE	PUT IN	PULLED OUT
				10-3/4"	216'	None
				7"	3744'	3253'

Describe in detail the manner in which the well was plugged, indicating where the mud fluid was placed and the method or methods used in introducing it into the hole. If cement or other plugs were used, state the character of same and depth placed, from \_\_\_\_\_ feet to \_\_\_\_\_ feet for each plug set.

Checked hole to 3776', sanded hole to 3735' and dumped 5 sacks of cement @ 3735' with dump bailer. Pulled 7" casing, checked fluid to 470', filled with salt water to 220', set rock bridge to 205' and dumped 20 sacks of cement @ 205'. Mudded hole to 20' and ran 10 sacks of cement to base of cellar.

RECEIVED  
STATE CORPORATION COMMISSION

MAR 22 1966

CONSERVATION DIVISION  
Wichita, Kansas

PLUGGING COMPLETE.

3-22-66

(If additional description is necessary, use BACK of this sheet)  
Name of Plugging Contractor KNIGHT CASING PULLING COMPANY  
Address CHASE, KANSAS

STATE OF KANSAS COUNTY OF RICE, ss. Noel J. Knight

(employee of owner) or (owner) of the above-described well, being first duly sworn on oath, says: That I have knowledge of the facts, statements, and matters herein contained and the log of the above-described well as filed and that the same are true and correct. So help me God.

(Signature) Paul J. Knight  
Chase, Kansas  
(Address)

SUBSCRIBED AND SWORN TO before me this 19th day of March, 1966

Milton J. Volin  
Notary Public.

My commission expires May 20, 1968

Tract 16  
 COPY

Shallow Water Pzdg

Company: W. C. MCBRIDE, INC.  
 Farm: Dicoffenbacher No. 3

SEC. 31 T. 27 R. 4W  
 NW SE SE  
 1648' fr WL 990' fr SL


Bartholomew Unit Tract 16 Well #3

Total Depth: 3776  
 Comm. 3-21-51  
 Shot or Traced:

Comp. 4-24-51

County Sedgwick  
 KANSAS

Contractor: Jackson Drlg. Corp. & O. H. Tico Drlg. Co.  
 Issue: 5-31-52

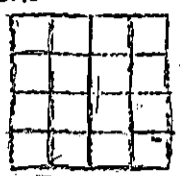

CASING:

10 3/4" 2161' ccm.  
 7" 3744' ccm.

Stratigraphic Unit DE

Production: IPP 496 BO & 3% wtr.

Figures indicate Bottom of Formation.

clay & shale	40
sandy shale	65
shale & shells	590
shale & lime	2940
lime	3055
lime & shale	3085
lime	3240
lime & shale	3708
lime & chert	3776
Total Depth	

Tops:

Brown Lime	2841
Lansing K.J.	2884
Miss.	3708
Dolomite	3754

4-12-51 Cleaned out to bottom  
 3763' Acidized w/1000 gal. acid.  
 Tested 4 hrs. 15 gal. fluid scum  
 of oil. Perfejet with 39 shots  
 3741 to 3756. Acidized w/1000  
 gals. acid, tested 16.8 BO and  
 14.7 BW 24 hrs. small amount of  
 gas 4-22-51 Strata lift with  
 750 gal. Jcl acid, 1500 gal.  
 acid Swab test 4-23-51  
 12 hrs. 50 BO 25 BW

RECEIVED  
 STATE CORPORATION COMMISSION  
 FEB 10 1966  
 CONSERVATION DIVISION  
 Wichita, Kansas