

CARD MUST BE TYPED

State of Kansas
NOTICE OF INTENTION TO DRILL

CARD MUST BE SIGNED

(see rules on reverse side)

Starting Date: 10 5 84
month day year

API Number 15-151-21,486-00-00

OPERATOR: License # 6393
Name BROUGHER OIL, INC.
Address P. O. Drawer 1367
City/State/Zip Great Bend, KS 67530
Contact Person Joe E. Brougher
Phone 316-793-5610

NW NW SE 22 28 15
(location) Sec Twp S, Rge East West

CONTRACTOR: License # 6394
Name MOHAWK DRILLING, INC.
City/State Great Bend, KS 67530

2310 Ft North from Southeast Corner of Section
2310 Ft West from Southeast Corner of Section
(Note: Locate well on Section Plat on reverse side)

Well Drilled For: Well Class: Type Equipment:
 Oil Swd Infield Mud Rotary
 Gas Inj Pool Ext. Air Rotary
 OWWO Expl Wildcat Cable

Nearest lease or unit boundary line 330' North & West feet.
County Pratt
Lease Name FRAZIER Well# 1
Domestic well within 330 feet: yes no
Municipal well within one mile: yes no

If OWWO: old well info as follows:
Operator
Well Name
Comp Date Old Total Depth 4850' feet
Projected Total Depth
Projected Formation at TD Arbuckle
Expected Producing Formations Kansas City, Viola & Simpson Sand

Depth to Bottom of fresh water 195-120 feet
Lowest usable water formation Unknown
Depth to Bottom of usable water Unknown 250 feet
Surface pipe by Alternate: 1 2
Surface pipe to be set 450 feet
Conductor pipe if any required None feet
Ground surface elevation Unknown feet MSL
This Authorization Expires 3-25-85
Approved By 7-25-84 K


I certify that we will comply with K.S.A. 55-101, et seq., plus eventually plugging hole to K.C.C. specifications.

Date 9-24-84 Signature of Operator or Agent Joe E. Brougher Title President

Must be filed with the K.C.C. five (5) days prior to commencing well
This card void if drilling not started within six (6) months of date received by K.C.C.

Important procedures to follow :

A Regular Section of Land
1 Mile = 5,280 Ft.

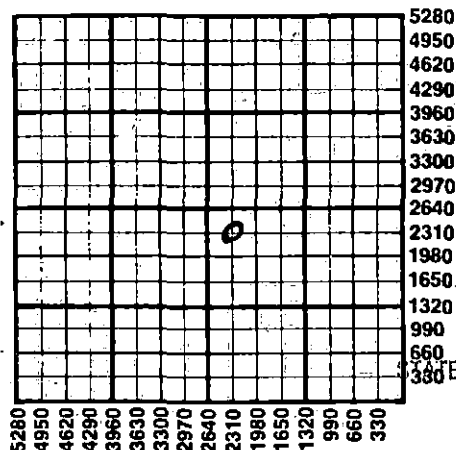

1. Notify District office before setting surface casing.
2. Set surface casing by circulating cement to the top.
3. File completion forms ACO-1 with K.C.C. within 90 days of well completion, following instructions on ACO-1, side 1, and including copies of wireline logs.
4. Notify District office 48 hours prior to old well workover or re-entry.
5. Prior to plugging, prepare a plugging plan, then obtain agreement from the appropriate district office for an approved plugging plan.
6. Submit plugging report (CP-4) to K.C.C. after plugging is completed.
7. Obtain an approved injection docket number before disposing of salt water.
8. Notify K.C.C. within 10 days when injection commences or terminates.
9. If an alternate 2 completion, cement in the production pipe from below any usable water to surface within 120 days of spud date.

RECEIVED
STATE CORPORATION COMMISSION
SEP 25 1984
CONSERVATION DIVISION
Wichita, Kansas

State Corporation Commission of Kansas
Conservation Division
200 Colorado Derby Building
Wichita, Kansas 67202
(316) 263-3238