

CARD MUST BE TYPED.

State of Kansas
NOTICE OF INTENTION TO DRILL
(see rules on reverse side)

CARD MUST BE SIGNED

Starting Date: 8-10-85
month day year 9:18

OPERATOR: License # 8625
Name VAC Petroleum Co.
Address 333 N. Rock Rd. Suite 105
City/State/Zip Wichita, Ks. 67206
Contact Person L.C. Harmon
Phone (316) 685-0111

CONTRACTOR: License # 5829
Name Aldebaran Drilling Co.
City/State Wichita, Ks. 67218

Well Drilled For: Well Class: Type Equipment:
 Oil Swd Infield Mud Rotary
 Gas Inj Pool Ext. Air Rotary
 OWWO Expl Wildcat Cable

If OWWO: old well info as follows:

Operator
Well Name
Comp Date Old Total Depth
Projected Total Depth 4800 feet
Projected Formation at TD Simpson
Expected Producing Formations LKC, Marmaton, Viola, Simp.

API Number 15- 151-21,673-00-00
SE NE NW Sec 34. Twp 28. S, Rge 25 East
(location) West

4290 Ft North from Southeast Corner of Section
2970 Ft West from Southeast Corner of Section
(Note: Locate well on Section Plat on reverse side)

Nearest lease or unit boundary line 330 feet.
County Pratt
Lease Name Moore Well# 2

Domestic well within 330 feet: yes no
Municipal well within one mile: yes no

Depth to Bottom of fresh water 170 feet
Lowest usable water formation
Depth to Bottom of usable water 225 feet
Surface pipe by Alternate: 1 2
Surface pipe to be set 450 feet
Conductor pipe if any required None feet
Ground surface elevation N/A feet MSL
This Authorization Expires 2-8-86

Approved By 8-8-85 [Signature]

I certify that we will comply with K.S.A. 55-101, et seq., plus eventually plugging hole to K.C.C. specifications.

Date 8-8-85 Signature of Operator or Agent [Signature] Title Agent

Must be filed with the K.C.C. five (5) days prior to commencing well
This card void if drilling not started within six (6) months of date received by K.C.C.

RECEIVED
STATE CORPORATION COMMISSION

8-8-85

Important procedures to follow:

A Regular Section of Land
1 Mile = 5,280 Ft.

AUG 8 1985

1. Notify District office before setting surface casing.

2. Set surface casing by circulating cement to the top.

3. File completion forms ACO-1 with K.C.C. within 90 days of well completion, following instructions on ACO-1, side 1, and including copies of wireline logs.

4. Notify District office 48 hours prior to old well workover or re-entry.

5. Prior to plugging, prepare a plugging plan, then obtain agreement from the appropriate district office for an approved plugging plan.

6. Submit plugging report (CP-4) to K.C.C. after plugging is completed.


7. Obtain an approved injection docket number before disposing of salt water.

8. Notify K.C.C. within 10 days when injection commences or terminates.

9. If an alternate 2 completion, cement in the production pipe from below any usable water to surface within 120 days of spud date.

CONSERVATION DIVISION

Wichita, Kansas

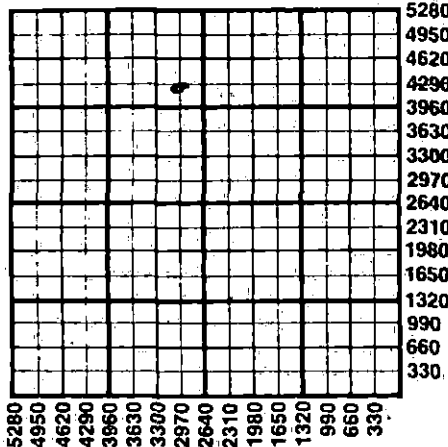

State Corporation Commission of Kansas
Conservation Division
200 Colorado Derby Building
Wichita, Kansas 67202
(316) 263-3238