

STATE OF KANSAS
STATE CORPORATION COMMISSION

15-097-20672-0000

WELL PLUGGING RECORD

Give All Information Completely
Make Required Affidavit
Mail or Deliver Report to
Conservation Division
State Corporation Comm.
245 North Water
Wichita, KS 67202

Kiowa County, Sec. 36 Twp. 28S Rge. 19 E/W
Location as "NE/CNW 1/4 SW 1/4" or footage from lines
SW SE


Lease Owner Petrosil Exploration Inc.
Lease Name UNRUH Well No. 1
Office Address 2100, 6730 LBJ Frwy, Dallas, TX 75240
Character of Well (Completed as Oil, Gas or Dry Hole)
DRY HOLE

Date Well completed N/A 19
Application for plugging filed 1/9/81 19
Application for plugging approved 19
Flugging commenced 12/24/80 19
Plugging completed 12/25/80 19
Reason for abandonment of well or producing formation
Dry Hole

If a producing well is abandoned, date of last production
N/A 19

Was permission obtained from the Conservation Division or
its agents before plugging was commenced? Yes

Name of Conservation Agent who supervised plugging of this well
Producing formation N/A Depth to top Bottom Total Depth of Well 5005'
Show depth and thickness of all water, oil and gas formations.

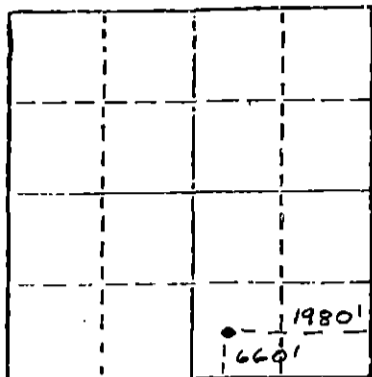

Locate well correctly on above
Section Plat

OIL, GAS OR WATER RECORDS

CASING RECORD

FORMATION	CONTENT	FROM	TO	SIZE	PUT IN	PULLED OUT
Surface Casing				10 3/4	314'	None

Describe in detail the manner in which the well was plugged, indicating where the mud fluid was placed and the method or methods used in introducing it into the hold. If cement or other plugs were used, state the character of same and depth placed, from feet to feet for each plug set.

Set 4" OD Drill Pipe @ 600', open-ended. Pumped 50 sx 50-50 cmt w/3% CaCl₂
Top of plug (Calc.) 434'

Set 4" OD Drill Pipe @ 330', open-ended. Pumped 50 sx 50-50 cmt w/ 3% CaCl₂
Top of plug (Calc.) 164'

Set 4" OD Drill Pipe @ 40', open-ended. Pump 50 sx 50-50 cmt w/ 3% CaCl₂ to
0' (Surface). Circ.

Pumped 15 sx cmt each in rat hole and mouse hole.

(If additional description is necessary, use BACK of this sheet)

Name of Plugging Contractor Halliburton

STATE OF Texas COUNTY OF Dallas, ss.
H. Timm (employee of owner) or (owner or operator)
of the above-described well, being first duly sworn on oath, says: That I have knowledge of the facts, statements, and matters herein contained and the log of the above-described well as filed and that the same are true and correct. So help me God.

(Signature) *H. Timm*
2100, 6730 LBJ Frwy., Dallas, TX 75240
(Address)

SUBSCRIBED AND SWORN TO before me this 12th day of January, 1981

Kerry O'Neill
Notary Public.

My commission expires 10-21-81

KERRY ONEILL
Notary Public In and For
Dallas County, Texas

RECEIVED
STATE CORPORATION COMMISSION
1-15-81
JAN 15 1981
CONSERVATION DIVISION
Wichita, Kansas