


WELL PLUGGING RECORD

Give All Information Completely  
Map Required Affidavit  
Mail or Deliver Report to:  
Conservation Division  
State Corporation Commission  
211 No. Broadway  
Wichita, Kansas

Kiowa County, Sec. 1 Twp. 28S Rge. ~~19~~ 19 (W)  
Location as "NE/CNW/SW" or footage from lines. 2016' NSL & 1976' WEL  
Lease Owner Gulf Oil Corporation  
Lease Name E. M. Pyle Well No. 1  
Office Address 316 Union Center Bldg., Wichita, Kansas 67202  
Character of Well (completed as Oil, Gas or Dry Hole) Dry hole  
Date well completed (Temporarily abandoned) 10-19, 1965  
Application for plugging filed No (discussed w/Mr. Greider) 12-10, 1965  
Application for plugging approved 19  
Plugging commenced (Partial) 10-19-65 & 12-28-65 -See below 19  
Plugging completed 19  
Reason for abandonment of well or producing formation Dry hole

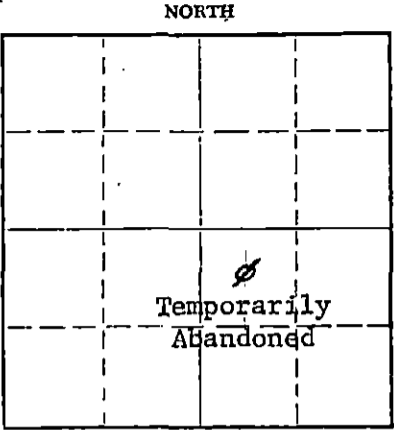

Locate well correctly on above Section Plat

If a producing well is abandoned, date of last production -- 19--  
Was permission obtained from the Conservation Division or its agents before plugging was commenced? Yes

Name of Conservation Agent who supervised plugging of this well Archie V. Elving  
Producing formation \_\_\_\_\_ Depth to top \_\_\_\_\_ Bottom \_\_\_\_\_ Total Depth of Well 4971 Feet  
Show depth and thickness of all water, oil and gas formations.

OIL, GAS OR WATER RECORDS

CASING RECORD

FORMATION	CONTENT	FROM	TO	SIZE	PUT IN	PULLED OUT
				8-5/8" OD	397'	None
				4-1/2" OD	4959' **	3846'
						* Set at 408'
						** Set at 4970'

Describe in detail the manner in which the well was plugged, indicating where the mud fluid was placed and the method or methods used in introducing it into the hole. If cement or other plugs were used, state the character of same and depth placed, from \_\_\_\_\_ feet to \_\_\_\_\_ feet for each plug set.

Well was drilled to total depth of 4971'. After testing dry, a 27 sack cement plug was placed inside the 4 1/2" casing with the top of the plug at 4650' on 10-19-65. The well was temporarily abandoned and held for possible use as a disposal well. On December 28, 1965, the 4-1/2" casing was ripped at 3900' & 3846' of 4 1/2" recovered for use elsewhere. Hole filled with mud to base of 8-5/8" at 408'. A swage nipple and valve were installed on top of the 8-5/8" casing. The well is being taken over by Woods Petroleum Corporation for conversion to a salt water disposal well. Copy of their letter of March 4, 1966, is attached.

RECEIVED  
STATE CORPORATION COMMISSION

JUL 6 1966

CONSERVATION DIVISION  
Wichita, Kansas

(If additional description is necessary, use BACK of this sheet)

Name of Plugging Contractor \_\_\_\_\_  
Address \_\_\_\_\_

STATE OF KANSAS COUNTY OF SEDGWICK, ss.  
G. V. Kersten (employee of owner) ~~owner or operator~~

well, being first duly sworn on oath, says: That I have knowledge of the facts, statements, and matters herein contained and the log of the above-described well as filed and that the same are true and correct. So help me God.

(Signature) G. V. Kersten  
316 Union Center Bldg., Wichita, Kansas 67202  
(Address)

SUBSCRIBED AND SWORN to before me this 5th day of July, 1966

My commission expires 2-4-67 Ray W. Rouser Notary Public.