

STATE OF KANSAS
STATE CORPORATION COMMISSION

Give All Information Completely
Make Required Affidavit
Mail or Deliver Report to:
Conservation Division
State Corporation Commission
212 No. Market
Wichita, Kansas

WELL PLUGGING RECORD

Kiowa County, Sec. 35 Twp. 28S Rge. (E) 19(W)

Location as "NE/CNWSW" or footage from lines NW NE

Lease Owner Shenandoah Oil Corporation

Lease Name Unruh Well No. 1

Office Address 1018 Commerce Bldg., Ft. Worth, Texas

Character of Well (completed as Oil, Gas or Dry Hole) Gas

Date well completed December 13, 19 66

Application for plugging filed April 16 19 69

Application for plugging approved June 4 19 69

Plugging commenced 7-14 19 69


Plugging completed 7-21 19 69

Reason for abandonment of well or producing formation Non-

commercial

If a producing well is abandoned, date of last production February 19 69

Was permission obtained from the Conservation Division or its agents before plugging was commenced? Yes

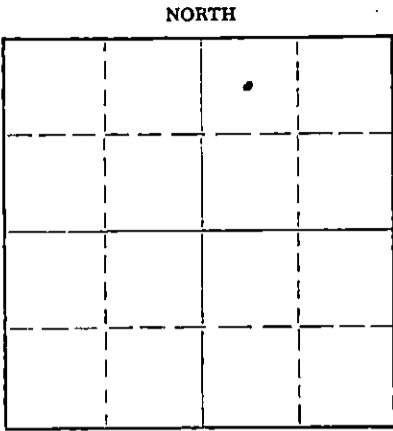

Locate well correctly on above Section Plat

Name of Conservation Agent who supervised plugging of this well

Producing formation Mississippian Depth to top 4921 Bottom 4941 Total Depth of Well 4941 Feet

Show depth and thickness of all water, oil and gas formations.

OIL, GAS OR WATER RECORDS

CASING RECORD

FORMATION	CONTENT	FROM	TO	SIZE	PUT IN	PULLED OUT
Mississippian	Gas	4926		8-5/8"	301'	None
				4-1/2"	4941'	3545.01'

Describe in detail the manner in which the well was plugged, indicating where the mud fluid was placed and the method or methods used in introducing it into the hole. If cement or other plugs were used, state the character of same and depth placed, from feet to feet for each plug set.

A 10 sack cement plug was pumped to 4700 feet with mud laden fluid. Pipe was shot free at 3520 feet and pulled. A bridge was set 50 feet below surface pipe. Cemented surface with 3 yards of concrete.

RECEIVED
STATE CORPORATION COMMISSION
AUG 7 1969
CONSERVATION DIVISION
Wichita, Kansas

Name of Plugging Contractor Clyde A. Reeves & Son, Inc.
Address P. O. Box 94204, Oklahoma City, Oklahoma

STATE OF Texas, COUNTY OF Tarrant, ss.
W. E. Williams (employee of owner) or (employee or operator) of the above-described well, being first duly sworn on oath, says: That I have knowledge of the facts, statements, and matters herein contained and the log of the above-described well as filed and that the same are true and correct. So help me God.

(Signature) [Signature]
1018 Commerce Bldg., Fort Worth, Texas (Address)

SUBSCRIBED AND SWORN TO before me this 6th day of August, 19 69

[Signature]
Notary Public.

My commission expires June 1, 1971

35-28-19W

15-097-30172-0000 *EP*

GABBERT-JONES, INC.
WICHITA, KANSAS
DRILLERS' WELL LOG

RECEIVED
STATE CORPORATION COMMISSION
AUG 19 1969
CONSERVATION DIVISION
Wichita, Kansas

ALLEN C. UNRUH #1
C NW NE SECTION 35-28S-19W
KIOWA COUNTY, KANSAS

COMMENCED: NOVEMBER 14, 1966
COMPLETED: NOVEMBER 29, 1966

OPERATOR - SHENANDOAH OIL CORPORATION

DEPTH		FORMATION	REMARKS
FROM	TO		
0	90	TOP SOIL AND SAND	
90	110	SAND	
110	301	SHALE	RAN 304' OF 8-5/8" CASING, SET @ 301' w/275 SACKS CEMENT.
301	610	SHALE AND SAND	
610	625	BLAINE ANHYDRITE	
625	1206	SHALE AND RED BED	
1206	1234	ANHYDRITE	
1234	2350	SHALE	
2350	2990	LIME	
2990	3955	LIME AND SHALE	
3955	4805	LIME	
4805	4865	LIME AND SHALE	
4865	4941	LIME	
4941	TD		SET 4939' OF 4 1/2" CASING, SET @ 4939' w/100 SACKS CEMENT.

I, E. E. HALL, CERTIFY THIS IS A CORRECT COPY OF THE DRILLERS' LOG FOR THE WELL DRILLED IN THE C NW NE SECTION 35-28S-19W, KIOWA COUNTY, KANSAS, TO THE BEST OF MY KNOWLEDGE AND BELIEF.

E. E. Hall

E. E. HALL

STATE OF KANSAS)
) SS
COUNTY OF SEDGWICK)

BEFORE ME, THE UNDERSIGNED, A NOTARY PUBLIC WITHIN AND FOR SAID COUNTY AND STATE, ON THIS 30TH DAY OF NOVEMBER, 1966, PERSONALLY APPEARED E. E. HALL, TO ME PERSONALLY KNOWN TO BE THE IDENTICAL PERSON WHO EXECUTED THE WITHIN AND FOREGOING INSTRUMENT AND ACKNOWLEDGED TO ME THAT HE EXECUTED THE SAME AS HIS FREE AND VOLUNTARY ACT AND DEED FOR THE USES AND PURPOSES THEREIN SET FORTH.

IN WITNESS WHEREOF, I HAVE HEREUNTO SET MY HAND AND OFFICIAL SEAL THE DAY AND YEAR LAST ABOVE WRITTEN.

Barbara J. Layton

BARBARA J. LAYTON, NOTARY PUBLIC

My Commission Expires February 1, 1968.

