


STATE OF KANSAS
STATE CORPORATION COMMISSION

15-097-20149-0000
Form CP-4

WELL PLUGGING RECORD

Give All Information Completely
Make Required Affidavit
Mail or Deliver Report to:
Conservation Division
State Corporation Commission
211 No. Broadway
Wichita, Kansas

Location as "NE/CNW/SW" or footage from lines 17 Twp. 28S, Rge. 19 (E) X (W) X
Lease Owner Mahoney Drilling Co., Inc. 402 E. Park Liberal, Kansas 67901
Lease Name Pomar Well No. 1
Office Address _____
Character of Well (completed as Oil, Gas or Dry Hole) Dry Hole
Date well completed 12/11 1972
Application for plugging filed 1/18/73, 4/30/73 19
Application for plugging approved 1/19/73, 5/1/73 19
Plugging commenced May 17 19 73
Plugging completed May 19 19 73
Reason for abandonment of well or producing formation DRY HOLE

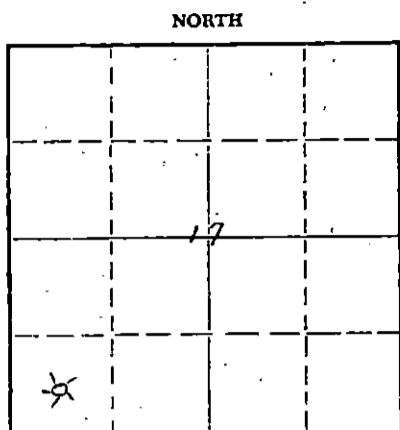

Locate well correctly on above Section Plat

If a producing well is abandoned, date of last production _____ 19____
Was permission obtained from the Conservation Division or its agents before plugging was commenced? Yes

Name of Conservation Agent who supervised plugging of this well Russell Biblhorstein
Producing formation _____ Depth to top _____ Bottom _____ Total Depth of Well 4969 Feet
Show depth and thickness of all water, oil and gas formations.

OIL, GAS OR WATER RECORDS

CASING RECORD

FORMATION	CONTENT	FROM	TO	SIZE	PUT IN	PULLED OUT

Describe in detail the manner in which the well was plugged, indicating where the mud fluid was placed and the method or methods used in introducing it into the hole. If cement or other plugs were used, state the character of same and depth placed, from _____ feet to _____ feet for each plug set.

15 sks. cement @ 4180 to 4350
35 sks. cement @ 400 ft.
fill hole with mud to 40 ft.
Put 10 sks. cement @ 40 ft. to 0 ft.

RECEIVED
STATE CORPORATION COMMISSION
JUN 1 1973
CONSERVATION DIVISION
Wichita, Kansas

(If additional description is necessary, use BACK of this sheet)
Name of Plugging Contractor Sargents Casing Pulling Service
Address Box 506 Liberal, Kansas 67901

STATE OF KANSAS, COUNTY OF SEWARD, ss.
I, B. A. CLIFFT (employee of owner) or ~~(owner or operator)~~ of the above-described

well, being first duly sworn on oath, says: That I have knowledge of the facts, statements, and matters herein contained and the log of the above-described well as filed and that the same are true and correct. So help me God.

(Signature) B. A. Cliff
B. A. CLIFFT
Box 1257, Liberal, Kansas
(Address)

SUBSCRIBED AND SWORN to before me this 31ST day of MAY, 1973

My commission expires JANUARY 31, 1975
Jolene Dorsett
JOLENE DORSETT Notary Public.

WELL LOG

15-097-20149-0000

COMPANY Mahoney Drilling Company

SEC. 17 T. 28S R. 19W

FARM Pamar NO. 1


LOC. C SW SW

TOTAL DEPTH 4970'

COUNTY Kiowa, Kansas

COMM. 11-18-72 COMP. 11-28-72

CONTRACTOR Garvey Drilling Company

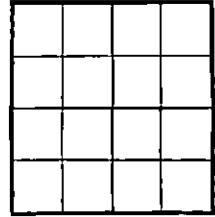

CASING

8 5/8" @ 607' w/425sx
4 1/2" Information - Tight Hole

ELEVATION

PRODUCTION

FIGURES INDICATE BOTTOM OF FORMATIONS

145' Sand
580' Shale
2435' Lime & Shale
2920' Lime
3970' Lime & Shale
4060' Lime
4970' Lime
4970' RTD

RECEIVED
STATE CORPORATION COMMISSION
DEC 19 1972
CONSERVATION DIVISION
Wichita, Kansas

State of Kansas }
County of Barton } as

I, Charlene Marker of Garvey Drilling Company

upon oath state the above and foregoing is a true and correct copy of the log of the Pamar #1 well.

Charlene Marker

Subscribed and sworn to before me this 5th day of December 1972

My Commission Expires: July 8, 1974

James C. Newman
NOTARY PUBLIC