


Give All Information Completely  
Make Required Affidavit  
Mail or Deliver Report to:  
Conservation Division  
State Corporation Commission  
211 No. Broadway  
Wichita, Kansas

15-097-10013-0000

WELL PLUGGING RECORD

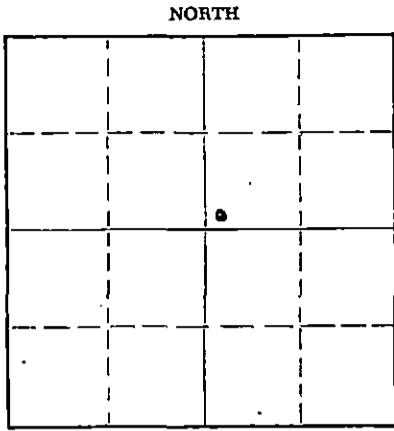

Locate well correctly on above Section Plat

Kiowa County. Sec. 17 Twp. 28S Rge. 19W (E)---(W)  
Location as "NE/CNW&SW&" or footage from lines. SW SW NE  
Lease Owner E. K. Carey Drilling Co., Inc.  
Lease Name McFadden Well No. 1  
Office Address 1050 Petroleum Club Building, Denver, Colorado  
Character of Well (completed as Oil, Gas or Dry Hole) Dry Hole  
Date well completed May 18 19 59  
Application for plugging filed May 18 19 59  
Application for plugging approved May 18 19 59  
Plugging commenced May 18 19 59  
Plugging completed May 18 19 59  
Reason for abandonment of well or producing formation no oil in commercial quantities.

If a producing well is abandoned, date of last production 19

Was permission obtained from the Conservation Division or its agents before plugging was commenced? yes By W. L. Lac Kamp, Stafford, Kansas

Name of Conservation Agent who supervised plugging of this well permission granted by Wichita Office, for that area

Producing formation \_\_\_\_\_ Depth to top \_\_\_\_\_ Bottom \_\_\_\_\_ Total Depth of Well 4980 Feet

Show depth and thickness of all water, oil and gas formations.

OIL, GAS OR WATER RECORDS

CASING RECORD

FORMATION	CONTENT	FROM	TO	SIZE	PUT IN	PULLED OUT
				8-5/8"	307'	none

Describe in detail the manner in which the well was plugged, indicating where the mud fluid was placed and the method or methods used in introducing it into the hole. If cement or other plugs were used, state the character of same and depth placed, from \_\_\_\_\_ feet to \_\_\_\_\_ feet for each plug set.

Filled hole with extra heavy rotary mud from total depth (4980') to 200'. Set Plug #1 at 200' with 20 sacks cement on top of plug. Filled hole with extra heavy rotary mud from plug #1 to 35'. Set plug #2 with 10 sacks cement to bottom cellar.

MAY 25 1959 5-25-59  
CONSERVATION DIVISION  
Wichita, Kansas

(If additional description is necessary, use BACK of this sheet)

Name of Plugging Contractor Capitt Drilling, Inc.  
Address 814 Union Center, Wichita, Kansas

STATE OF Kansas, COUNTY OF Sedgwick, ss.


R. R. McNicol (employee of owner) or (owner or operator) of the above-described well, being first duly sworn on oath, says: That I have knowledge of the facts, statements, and matters herein contained and the log of the above-described well as filed and that the same are true and correct. So help me God.

(Signature) R.R. McNicol  
814 Union Center, Wichita, Kansas  
(Address)

SUBSCRIBED AND SWORN to before me this 21st day of May, 19 59

My commission expires September 30, 1959

Darlene May  
Darlene May Notary Public.

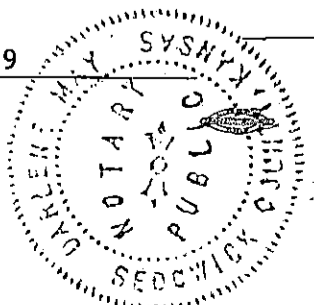

PLUGGING  
FILE SEC. 17 T. 28 R. 19W  
BOOK PAGE 42 LINE 23

ROTARY DRILLING LOG

OPERATOR: E. K. Carey Drilling Co., Inc.  
McFadden No. 1  
SW SW NE Sec. 17-28-19W,  
Kiowa County, Kansas

CONTRACTOR: Capitt Drilling, Inc.  
COMM: 5/4/59  
COMP: 5/18/59

Remarks: Set 312.53' of 8-5/8" surface casing at 307' cemented with 225 sacks #1 Pozmix, 2% C.C.

Formations:

Sandy clay	20'
Sand & Gravel	130'
Red Rock	220'
Shale	805'
Shale & Lime	1680'
Shale & Shells	1965'
Shale & Lime	2310'
Lime	3058'
Lime & Shale	3158'
Lime w/Shale Streaks	3275'
Lime & Chalky Lime	3405'
Shale & Lime	3555'
Lime & Shale	3680'
Lime & Chalky Lime	3760'
Chalky Lime	3880'
Lime	3975'
Lime & Chalky Lime	4080'
Lime	4980'
Rotary Total Depth (D&A)	4980'

Seal  
MAY 25 1959  
CONSERVATION DIVISION  
Wichita, Kansas

We certify the above log is true and correct to the best of our knowledge and belief.

CAPITT DRILLING, INC.

*R. R. McNicol*

R. R. McNicol

PLUGGING  
FILE SEC 17 T. 28 R. 194  
BOOK PAGE 20 LINE 23