

STATE OF KANSAS  
STATE CORPORATION COMMISSION

Form CP-4


WELL PLUGGING RECORD

Give All Information Completely  
Make Required Affidavit  
Mail or Deliver Report to:  
Conservation Division  
State Corporation Commission  
212 No. Market  
Wichita, Kansas

KIOWA County. Sec. 15 Twp. 28S Rge. 19 (E) (W)

Location as "NE/CNW/SW" or footage from lines. C NE NW  
Lease Owner. PETROLEUM, INC.  
Lease Name. ROBERTSON 'E' Well No. 1  
Office Address. R.R. #2, GREAT BEND, KANSAS  
Character of Well (completed as Oil, Gas or Dry Hole) DRY HOLE  
Date well completed. NOVEMBER 18 19 66  
Application for plugging filed. NOVEMBER 18 19 66  
Application for plugging approved. NOVEMBER 18 19 66  
Plugging commenced. NOVEMBER 18 19 66  
Plugging completed. NOVEMBER 18 19 66  
Reason for abandonment of well or producing formation. NO PRODUCIBLE ZONE

NORTH

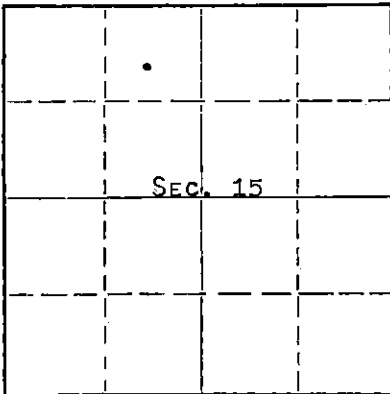

Locate well correctly on above  
Section Plat

If a producing well is abandoned, date of last production. NONE 19  
Was permission obtained from the Conservation Division or its agents before plugging was commenced? YES

Name of Conservation Agent who supervised plugging of this well. ARCHIE ELVING  
Producing formation. Depth to top. Bottom. Total Depth of Well. 4963' Feet  
Show depth and thickness of all water, oil and gas formations.

OIL, GAS OR WATER RECORDS

CASING RECORD

FORMATION	CONTENT	FROM	TO	SIZE	PUT IN	PULLED OUT
				8-5/8"	530'	NONE

Describe in detail the manner in which the well was plugged, indicating where the mud fluid was placed and the method or methods used in introducing it into the hole. If cement or other plugs were used, state the character of same and depth placed, from \_\_\_\_\_ feet to \_\_\_\_\_ feet for each plug set.

HEAVY MUD TO 300', 2 SACKS DRY CEMENT, 1/2 SACK HULLS, FOLLOWED BY WOODEN PLUG, PLACED 23 SACKS CEMENT ON TOP OF PLUG. HEAVY MUD TO 40', 1 SACK DRY CEMENT FOLLOWED BY WOODEN PLUG, PLACED 9 SACKS CEMENT ON TOP OF PLUG TO BASE OF WELL CELLAR.

RECEIVED  
CONSERVATION COMMISSION  
DEC 8 1966  
12-8-66  
CONSERVATION DIVISION  
WICHITA, KANSAS

(If additional description is necessary, use BACK of this sheet)

Name of Plugging Contractor. GARVEY DRILLING CO.  
Address. R.R. #2, GREAT BEND, KANSAS

STATE OF KANSAS, COUNTY OF BARTON, ss.  
MONTE CHADD (employee of owner) or (owner) of the above-described

well, being first duly sworn on oath, says: That I have knowledge of the facts, statements, and matters herein contained and the log of the above-described well as filed and that the same are true and correct. So help me God. MONTE CHADD, DIST. PROD. SUPT.

(Signature) *Monte Chadd*

R.R. #2, GREAT BEND, KANSAS  
(Address)

SUBSCRIBED AND SWORN to before me this 7 day of DECEMBER, 19 66

My commission expires MAY 28, 1969

*Richard H. Dunks*  
Notary Public.

# WELL LOG

15-097-30169-0000

COMPANY Petroleum, Incorporated

SEC. 15 T. 28S. R. 19W

FARM Robertson

NO. E-1

LOC. C NE NW


TOTAL DEPTH 4963'

COUNTY Kiowa

COMM. 11-3-66

COMP. 11-17-66

CONTRACTOR Garvey Drilling Company

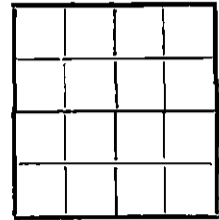

CASING 8 5/8" @ 370' w/450 sx

ELEVATION 2275' KB

PRODUCTION D & A

FIGURES INDICATE BOTTOM OF FORMATIONS

- 40' Sand
- 250' Sand and Gravel
- 1500' Shale
- 1825' Shale and Shells
- 2370' Lime and Shale
- 2690' Lime
- 3736' Lime and Shale
- 3750' Lime
- 4334' Lime and Shale
- 4457' Lime
- 4544' Lime and Shale
- 4585' Lime
- 4641' Lime and Shale
- 4905' Lime
- 4957' Chert
- 4963' Chert and Lime
- 4963' RTD

**RECEIVED**  
STATE CORPORATION COMMISSION  
DEC 8 1966  
CONSERVATION DIVISION  
Topeka, Kansas

State of Kansas }  
County of Barton } ss

I, Sam N. Stephens of Garvey Drilling Company

upon oath state the above and foregoing is a true and correct copy of the log of the Robertson No. E-1 well.

*Sam N. Stephens*

Subscribed and sworn to before me this 6th day of December 19 66

My Commission Expires: November 5, 1969

*Richard Doy*  
NOTARY PUBLIC