


15-097-00120-0000

STATE OF KANSAS
STATE CORPORATION COMMISSION
Give All Information Completely
Make Required Affidavit
Mail or Deliver Report to:
Conservation Division
State Corporation Commission
211 No. Broadway
Wichita, Kansas

WELL PLUGGING RECORD

Kiowa County. Sec. 14 Twp 28 Rge. 19 (X) W (W)
Location as "NE/CNWSW" or footage from lines C, SE/4 1320' F/N & E Line
Lease Owner E. K. Carey Drilling Co., Inc. of SE/4
Lease Name W. E. Rice Well No. 1
Office Address P. O. Box 620, McPherson, Kansas
Character of Well (completed as Oil, Gas or Dry Hole) Dry hole
Date well completed June 12, 1958
Application for plugging filed June 12, 1958
Application for plugging approved June 12, 1958
Plugging commenced 5 P.M. June 12, 1958
Plugging completed 10:30 P.M. June 12, 1958
Reason for abandonment of well or producing formation Dry hole

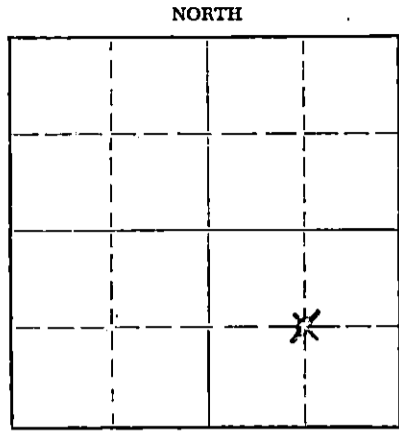

Locate well correctly on above Section Plat

If a producing well is abandoned, date of last production 19
Was permission obtained from the Conservation Division or its agents before plugging was commenced? Yes

Name of Conservation Agent who supervised plugging of this well W. L. Lackamp Jr. Stafford, Kansas
Producing formation Depth to top Bottom Total Depth of Well 4923 Feet
Show depth and thickness of all water, oil and gas formations.

OIL, GAS OR WATER RECORDS CASING RECORD

FORMATION	CONTENT	FROM	TO	SIZE	PUT IN	PULLED OUT
				8-5/8"	297'	None

Describe in detail the manner in which the well was plugged, indicating where the mud fluid was placed and the method or methods used in introducing it into the hole. If cement or other plugs were used, state the character of same and depth placed, from 287-227 feet to 38-8 feet for each plug set.

From 4923 filled hole to 300 feet from top with heavy drilling mud. Pushed first plug down to 287 feet from top of hole, mixed 20 sacks cement in barrel and poured down drill pipe. Layed down all drill pipe but 1 joint, filled hole from first plug to 38 feet from top with heavy drilling mud. Set top plug at 38 feet with 10 sacks cement on top of plug, which filled hole to bottom of cellar on 6-12-58 at 10:30 P.M.

RECEIVED
STATE CORPORATION COMMISSION

JUN 18 1958 6-18-58

CONSERVATION DIVISION
Wichita, Kansas

(If additional description is necessary, use BACK of this sheet)
Name of Plugging Contractor Capitt Drilling, Inc., Rig
Address 814 Union Center, Wichita, Kansas

STATE OF Kansas COUNTY OF McPherson, ss.
Gene Osburn, Prod. Supt. (employee of owner) or (owner or operator) of the above-described well, being first duly sworn on oath, says: That I have knowledge of the facts, statements, and matters herein contained and the log of the above-described well as filed and that the same are true and correct. So help me God.

(Signature) G.E. Osburn Prod. Supt.
Box 620, McPherson, Kansas (Address)

SUBSCRIBED AND SWORN TO before me this 13th day of June, 1958

My commission expires November 13, 1960

Notary Public.

PLUGGING
FILE SEC 14 T 28 R 19W
BOOK PAGE 109 LINE 4

15-097-00(20-0000

ROTARY DRILLING LOG

OPERATOR: E. K. Carey
W. E. RICE UNIT NO. 1
C SE/4 Sec. 14-28-19W,
Kiowa County, Kansas

CONTRACTOR: Capitt Drilling, Inc.
COMM: 5-26-58
COMP: 6-12-58

Remarks: Set 8-5/8" surface casing at
297' cemented with 250 sacks Pozmix, 2%
C.C.

Surface Soil & Clay	35'
Sand	250'
Shale	500'
Red Bed & Shale	850'
Shale & Shells	1500'
Shale & Brown Lime	1707'
Shale & Shells	2040'
Shale & Lime	2300'
Lime	2465'
Lime & Shale	2515'
Shale & Lime Shells	2590'
Lime & Shale	2913'
Lime	3015'
Brown Lime & Shale	3165'
Shale & Lime Streaks	3331'
Shale & Brown Lime	3476'
Shale & Lime	3570'
Shale & Lime Streaks	3680'
Shale & Lime Shells	3824'
Lime	4215'
Lime & Shale	4287'
Lime	4476'
Lime & Shale	4492'
Lime	4828'
Lime & Shale	4863'
Lime	4923'
Rotary Total Depth (D&A)	4923'

Geologist Tops:

Hoebner	4087 (-1826)
Douglas	4162 (-1901)
Bn. Lime	4246 (-1985)
Lansing K. C.	4254 (-1993)
Miss.	4363 (-2602)
Rotary Total Depth KB	4923

DST #1 - 4365 to 4870 or 5' anchor.
Tool open 2 hrs. good blow thru-out
test. Closed 30 min. for BHP. Recovered
30' drilling mud. BHP 2625%.

DST #2 - 4368 to 4878 or 10' anchor.
Tool open 2 hrs. good blow thru-out
test. Closed 35 min. for BHP. Recovered
30' of drilling mud. BHP 2625%.

We certify the above log is true and correct
to the best of our knowledge and belief.

CAPITT DRILLING, INC.

R. R. McNicol

R. R. McNicol

Subscribed and sworn to before me this 16th day of June, 1958.

My Commission Expires
September 30, 1959

Darlene May

Darlene May
Notary Public

RECEIVED
STATE CORPORATE COMMISSION

JUN 18 1958

CONSERVATION DIVISION
Wichita, Kansas

PLUGGING
FILE SEC. 14 T28 R. 19W
BOOK PAGE 109 LINE 4