


Give All Information Completely  
Make Required Affidavit  
Mail or Deliver Report to:  
Conservation Division  
State Corporation Commission  
212 North Market, Insurance Bldg.  
Wichita, Kansas

15-097-00118-0060

WELL PLUGGING RECORD

Kiowa  
Russell

County. Sec. 13 Twp. 28 Rge. 19 (E) (W)  
Location as "NE/CNW/SW" or footage from lines 960-960-center  
Lease Owner Homer E. Ogden, Callihan Inc.  
Lease Name Russell Well No. #1  
Office Address Kinsley, Kansas  
Character of Well (completed as Oil, Gas or Dry Hole) \_\_\_\_\_  
Date well completed \_\_\_\_\_ 19\_\_\_\_  
Application for plugging filed Yes 19\_\_\_\_  
Application for plugging approved Yes 19\_\_\_\_  
Plugging commenced \_\_\_\_\_ 10-2 1959  
Plugging completed \_\_\_\_\_ 10-7 1959  
Reason for abandonment of well or producing formation \_\_\_\_\_

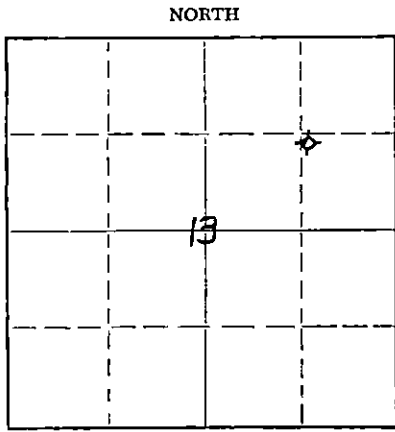

Locate well correctly on above Section Plat

If a producing well is abandoned, date of last production \_\_\_\_\_ 19\_\_\_\_  
Was permission obtained from the Conservation Division or its agents before plugging was commenced? Yes

Name of Conservation Agent who supervised plugging of this well Mr. La Camp  
Producing formation \_\_\_\_\_ Depth to top \_\_\_\_\_ Bottom \_\_\_\_\_ Total Depth of Well 4892' Feet  
Show depth and thickness of all water, oil and gas formations.

OIL, GAS OR WATER RECORDS

CASING RECORD

FORMATION	CONTENT	FROM	TO	SIZE	PUT IN	PULLED OUT
				8 5/8"	surface	
				5 1/2"	casing	3,283'

Describe in detail the manner in which the well was plugged, indicating where the mud fluid was placed and the method or methods used in introducing it into the hole. If cement or other plugs were used, state the character of same and depth placed, from \_\_\_\_\_ feet to \_\_\_\_\_ feet for each plug set.

Measured into T.D. 4892'.  
Plugging started 10-2-59. Finished 10-7-59.  
Plugged off bottom and sanded back to 4350'. Dumped 5 sacks of cement. Worked and shot pipe. Shot 5 1/2" casing at 3,283'.  
Pulled pipe out of hole and plugged well as follows: Mudded to 300'. Set rock bridge and dumped 25 sacks of cement. Filled hole with mud to 40'. Set rock bridge and capped well with 10 sacks of cement. Well completed.

RECEIVED  
STATE CORPORATION COMMISSION  
OCT 16 1959  
CONSERVATION DIVISION  
Wichita, Kansas

(If additional description is necessary, use BACK of this sheet)  
Name of Plugging Contractor J.O. Forbes d/b/a Forbes Casing Pulling Co.  
Address Box 221, Great Bend, Kansas

STATE OF Kansas, COUNTY OF Kansas Barton, ss.  
J.O. Forbes (employee of owner) or (owner or operator) of the above-described well, being first duly sworn on oath, says: That I have knowledge of the facts, statements, and matters herein contained and the log of the above-described well as filed and that the same are true and correct. So help me God.

(Signature) J.O. Forbes  
Box 221, Great Bend, Kans (Address)

SUBSCRIBED AND SWORN TO before me this 13<sup>th</sup> day of October, 1959  
Betty S. Edman Notary Public.

My commission expires November 8, 1960

WELL LOG BUREAU—KANSAS GEOLOGICAL SOCIETY  
508 East Murdock, Wichita, Kansas

COPY

15-097-00118-0000


Company- HOMER ODGEN, ET AL  
Farm- Russell No. 1

SEC. 13 T. 28 R. 19W  
NW SE NE

Total Depth. 4890'  
Comm. 6-25-58 Comp. 7-4-58  
Shot or Treated.  
Contractor. Glen Peel  
Issued. 3-18-61

County Kiowa

KANSAS

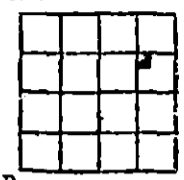

CASING:  
8" 301'  
5" 4400'

Elevation. 2255' RB

Production. 15 BOPD

Figures Indicate Bottom of Formations.

COMPLETE DRILLERS LOG NOT AVAILABLE

TOPS: SCOUT  
Lansing 4240  
Mississippi 4830  
Total Depth 4890