

15-097-1043-0000

STATE OF KANSAS  
STATE CORPORATION COMMISSION

All Information Completely  
Make Required Affidavit  
Mail or Deliver Report to:  
Conservation Division  
State Corporation Commission  
212 North Market, Insurance Bldg.  
Wichita, Kansas

WELL PLUGGING RECORD

KIOWA County. Sec. 13 Twp. 28s Rge. 19 W (W)

Location as "NE/CNW/SW" or footage from lines. C SW NW

Lease Owner PETROLEUM, INC.

Lease Name BECKER Well No. 1

Office Address ROUTE 2, GREAT BEND, KANSAS

Character of Well (completed as Oil, Gas or Dry Hole) GAS

Date well completed OCTOBER 10 19 57

Application for plugging filed DECEMBER 29 19 58

Application for plugging approved JANUARY 5 19 59

Plugging commenced APRIL 17 19 59


Plugging completed APRIL 29 19 59

Reason for abandonment of well or producing formation \_\_\_\_\_

DEPLETION OF PRODUCIBLE ZONES

If a producing well is abandoned, date of last production NOVEMBER 1 19 58

Was permission obtained from the Conservation Division or its agents before plugging was commenced? YES

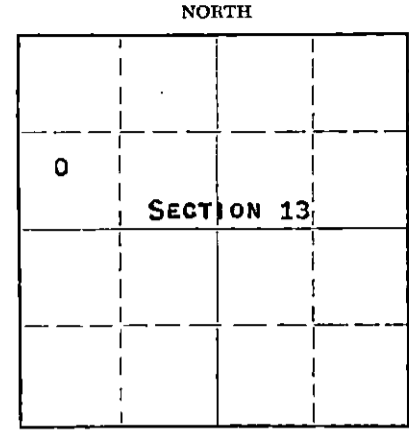

Locate well correctly on above Section Plat

Name of Conservation Agent who supervised plugging of this well W. L. LACKAMP

Producing formation MISS. Depth to top 4839 Bottom --- Total Depth of Well 4850 Feet

Show depth and thickness of all water, oil and gas formations.

OIL, GAS OR WATER RECORDS

CASING RECORD

FORMATION	CONTENT	FROM	TO	SIZE	PUT IN	PULLED OUT
MISSISSIPPI	WATER &	4842'	4850'	8-5/8"	365'	NONE
	LITTLE GAS			4-1/2"	4842'	2800'

Describe in detail the manner in which the well was plugged, indicating where the mud fluid was placed and the method or methods used in introducing it into the hole. If cement or other plugs were used, state the character of same and depth placed, from \_\_\_\_\_ feet to \_\_\_\_\_ feet for each plug set.

FILLED HOLE FROM 4850' TO 4832' WITH CRUSHED ROCK AND PLACED 5 SACKS CEMENT ON TOP OF ROCK. MUD UP WITH HEAVY MUD TO 350' AND MADE SOLID ROCK BRIDGE, PLACED 20 SACKS CEMENT ON TO ROCK BRIDGE AT 350'. MUDDER UP WITH HEAVY MUD TO 40' AND MADE SOLID ROCK BRIDGE. FILLED HOLE TO BASE OF WELL CELLAR WITH 10 SACKS CEMENT.

ST  
MAY 6 1959  
COMMISSION  
CONSERVATION DIVISION  
Wichita, Kansas

(If additional description is necessary, use BACK of this sheet)

Name of Plugging Contractor MORGAN WELL PLUGGING SERVICE

Address 102 WEST 18TH STREET, HUTCHINSON, KANSAS

STATE OF KANSAS, COUNTY OF BARTON, ss. DON SEARLE

(employee of owner) or (owner or operator) of the above-described well, being first duly sworn on oath, says: That I have knowledge of the facts, statements, and matters herein contained and the log of the above-described well as filed and that the same are true and correct. So help me God.

(Signature) Don Searle

ROUTE 2, GREAT BEND, KANSAS  
(Address)

SUBSCRIBED AND SWORN TO before me this 5th day of MAY, 19 59

My commission expires APRIL 14 1963  
Arthur J. Miles  
Notary Public.

PLUGGING  
FILE SEC 13 T 28 R 19  
BOOK PAGE 6 LINE 33

# WELL LOG

15-097-10143-0000

COMPANY PETROLEUM, INCORPORATED

SEC. 13 T. 28S R. 19W

FARM BECKER NO. 1


LOC. C/SW, NW

TOTAL DEPTH 4850'

COUNTY Kiowa Co., Kansas

COMM. September 6, 1957 COMP. September 19, 1957

CONTRACTOR GARVEY DRILLING COMPANY

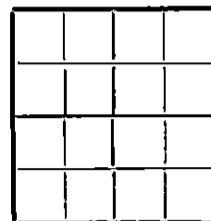

CASING 8 5/8" @ 365' W/300 sax.  
4 1/2" @ 4842' W/75 sax.

ELEVATION 2248' DF

PRODUCTION Mississippian

FIGURES INDICATE BOTTOM OF FORMATIONS

270	Surface soil & sand
365	Clay
500	Clay & sand
590	Red bed
620	Anhydrite
1600	Shale & shells
2055	Shale
2480	Lime & shale
2540	Lime
2813	Lime & shale
3405	Sandy lime & shale
3660	Shale & lime
3790	Shale & shells
3800	Shale
4132	Lime & shale
4250	Shale & sand
4295	Shale & lime
4535	Lime
4583	Broken Lime & shale
4629	Lime & shale
4730	Lime
4793	Lime & shale
4850	Sandy lime
4850	T. D.

RECEIVED  
STATE CORPORATION COMMISSION  
MAY 6 1959  
CONSERVATION DIVISION  
Wichita, Kansas

PLUGGING  
FILE SEC. 13 T. 28 R. 19W  
BOOK PAGE 6 LINE 33

State of KANSAS }  
County of BARTON } SS:

I, Verne A. Morris of Garvey Drilling Co.

upon oath state that the above and foregoing is a true and correct copy of the log of the #1 Becker well

Verne A. Morris

Subscribed and sworn to before me this 9th day of October 19 57

My Commission Expires: July 11, 1960

[Signature]  
NOTARY PUBLIC