

1 090017

8-13

API NUMBER 15-057-20,474-0000

To: STATE CORPORATION COMMISSION
CONSERVATION DIVISION - PLUGGING SECTION
200 COLORADO DERBY BUILDING
WICHITA, KANSAS 67202

W/2 SE SE, SEC. 33, T 29 S, R 24 W/X

660 feet from S section line

990 feet from E section line

TECHNICIAN'S PLUGGING REPORT

Operator License # 5123

Lease Name Moore Well # 1-W

Operator: Pickrell Drilling Company, Inc.
Name & Address 110 North Market, Suite 205
Wichita, KS 67202

County Ford 178.43

Well Total Depth 5490 feet

Conductor Pipe: Size _____ feet

Surface Casing: Size 8 5/8 feet 541

Abandoned Oil Well _____ Gas Well _____ Input Well _____ SWD Well _____ D&A X

Other well as hereinafter indicated _____

Plugging Contractor Pickrell Drilling Company, Inc. License Number 5123

Address 110 North Market, Suite 205, Wichita, KS 67202

Company to plug at: Hour: 6 p.m. Day: 13 Month: 8 Year: 19 89

Plugging proposal received from Doyle Folkert

(company name) Pickrell Drilling Company, Inc. (phone) 316-262-8427

were: to fill hole with heavy mud and spot cement through drill pipe Elevation 2586'

1st plug at 1535' with 50 sx cement, 2nd plug at 750' with 50 sx cement,

3rd plug at 570' with 50 sx cement,

4th plug at 40' with 10 sx cement,

5th plug to circulate rathole with 15 sx cement.

Plugging Proposal Received by Mike Wilson
(TECHNICIAN)

Plugging Operations attended by Agent?: All _____ Part _____ None X

Operations Completed: Hour: 8:30 p.m. Day: 13 Month: 8 Year: 19 89

ACTUAL PLUGGING REPORT 1st plug at 1535' with 50 sx cement,

2nd plug at 750' with 50 sx cement,

3rd plug at 570' with 50 sx cement,

4th plug at 40' with 10 sx cement,

5th plug to circulate rathole with 15 sx cement.

RECEIVED
STATE CORPORATION COMMISSION

AUG 15 1989
8-15-80
CONSERVATION DIVISION
Wichita, Kansas

Remarks: Used 60/40 Pozmix 6% gel by Allied.
(If additional description is necessary, use BACK of this form.)

INVOICED

(XXX) (dot) observe this plugging.

DATE 8-18-89

Signed Michael P. Wilson
(TECHNICIAN)

INV. NO. 25678
8-13

Must be approved by the K.C.C. five (5) days prior to commencing well

Expected Spud Date 8 4 89 month day year
W/2 SE SE Sec 33 Twp 29 S, Rg 24 East West

OPERATOR: License # 5123
Name: Pickrell Drilling Company, Inc.
Address: 110 N. Market, Suite 205
City/State/Zip: Wichita, KS 67202
Contact Person: Jay McNeil
Phone: 262-8427

CONTRACTOR: License #: 5123
Name: Company Tools

Well Drilled For: Well Class: Type Equipment:
X Oil ... Inj ... Infield X Mud Rotary
X Gas ... Storage ... Pool Ext. ... Air Rotary
... OAWO ... Disposal X Wildcat ... Cable
... Seismic; ... # of Holes

If OAWO: old well information as follows:
Operator:
Well Name:
Comp. Date: Old Total Depth

Directional, Deviated or Horizontal wellbore? yes X no
If yes, total depth location:

660 feet from South line of Section
990 feet from East line of Section
(Note: Locate well on Section Plat Below)

County: Ford
Lease Name: Moore Well #: 1-W
Field Name: Unknown
Is this a Prorated Field? yes X no
Target Formation(s): Morrow-Miss
Nearest lease or unit boundary: 660
Ground Surface Elevation: 2586 feet MSL
Domestic well within 330 feet: yes X no
Municipal well within one mile: yes X no
Depth to bottom of fresh water: 125' 225'
Depth to bottom of usable water: 200' 430'
Surface Pipe by Alternate: X 1 2
Length of Surface Pipe Planned to be set: 500'
Length of Conductor pipe required: none
Projected Total Depth: 5450
Formation at Total Depth: Mississippian
Water Source for Drilling Operations:
... well ... farm pond X other
DWR Permit #: N/A
Will Cores Be Taken?: yes X no
If yes, proposed zone:

AFFIDAVIT

450' Alt. I Req.

PUSHER Doyle Folkert

TD 5492 FORMATION Miss

SURFACE PIPE 858 @ 541'

ANHYDRITE ELEVATION 2586

STARTING TIME & DATE 6:00p 8-13-89

COMPLETION TIME & DATE 8:30p 8-13-89

1st PLUG @ 1535' FT. W/ 50' SX

2nd PLUG @ 750' FT. W/ 50' SX

3rd PLUG @ 570' FT. W/ 50' SX

4th PLUG @ 40' FT. W/ 10' SX

RAT HOLE CIRCULATED W/ 15' SX

MOUSE HOLE CIRCULATED W/ SX

WATER WELL PLUGGED W/ SX


CEMENT COMPANY Allied

TECHNICIAN Mike Wilson

TYPE OF CEMENT 10/40 per w/ 6%

SPUD 8-2-89
500-858
rww

RECEIVED
STATE CORPORATION COMMISSION
AUG 15 1989

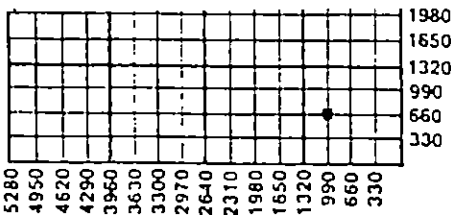

Spud date: _____ Age _____
CONSERVATION DIVISION
Wichita, Kansas

- REMEMBER TO:
- File Drill Pit Application (form CDP-1) with Intent to Drill;
- File Completion Form ACO-1 within 120 days of spud date;
- File acreage attribution plat according to field proration orders;
- Notify appropriate district office 48 hours prior to workover or re-entry;
- Submit plugging report (CP-4) after plugging is completed;
- Obtain written approval before disposing or injecting salt water.