

TYPE

AFFIDAVIT OF COMPLETION FORM

ACO-1 WELL HISTORY

SIDE ONE

Two (2) copies of this form shall be filed with the Kansas Corporation Commission, 200 Colorado Derby Building, Wichita, Kansas 67202, within thirty (30) days after the completion of a well, regardless of how the well was completed.

Attach separate letter of request if the information is to be held confidential. If confidential, only file one copy. Information on Side One will be of public record and Side Two will then be held confidential.

Applications must be made on dual completion, commingling, salt water disposal, injection and temporarily abandoned wells.

Attach one copy only wireline logs (i.e. electrical log, sonic log, gamma ray neutron log, etc.). (Rules 82-2-105 & 82-2-125) KCC# (316) 263-3238.

LICENSE # _____ EXPIRATION DATE _____

OPERATOR Associated Petroleum Consultants, Inc. API NO. 15-095-21,258-0000

ADDRESS Suite 600 - One Main Place COUNTY Kingman
Wichita, KS 67202-1399 FIELD _____

** CONTACT PERSON Phyllis Buchanan PROD. FORMATION None
PHONE (316) 265-9385

PURCHASER NONE LEASE Steffen

ADDRESS _____ WELL NO. #2

DRILLING Contractor Heartland Drilling, Inc. WELL LOCATION C W/2 SE

CONTRACTOR ADDRESS Suite 600 - One Main Place 1320' Ft. from North Line and
Wichita, KS 67202-1399 660' Ft. from West Line of

the SE/4(Tr.) SEC 12 TWP 29S RGE 10W.

PLUGGING Contractor Heartland Drilling, Inc.

CONTRACTOR ADDRESS Suite 600 - One Main Place

Wichita, KS 67202-1399

TOTAL DEPTH 2600' PBTD

SPUD DATE July 20, 1982 DATE COMPLETED July 24, 1982

ELEV: GR 1744 DF 1752 KB 1754


DRILLED WITH (CABLE) (ROTARY) (AIR) TOOLS.

DOCKET NO. OF DISPOSAL OR REPRESSURING WELL BEING USED TO DISPOSE OF WATER FROM THIS LEASE

Amount of surface pipe set and cemented 326' DV Tool Used? _____

THIS AFFIDAVIT APPLIES TO: (Circle ONE) - Oil, Gas, Shut-in Gas, (Dry) Disposal, Injection, Temporarily Abandoned, OWWO. Other _____

ALL REQUIREMENTS OF THE STATUTES, RULES AND REGULATIONS PROMULGATED TO REGULATE THE OIL AND GAS INDUSTRY HAVE BEEN FULLY COMPLIED WITH.

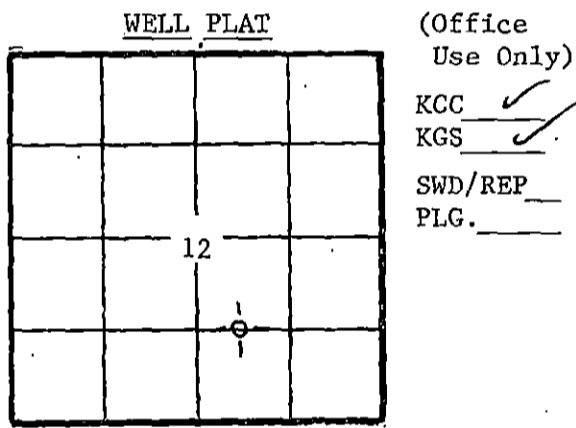


A F F I D A V I T

PHYLLIS BUCHANAN, being of lawful age, hereby certifies that:

I am the Affiant, and I am familiar with the contents of the foregoing Affidavit. The statements and allegations contained therein are true and correct.

Phyllis Buchanan
PHYLLIS BUCHANAN (Name)

SUBSCRIBED AND SWORN TO BEFORE ME this 30th day of July, 1982.

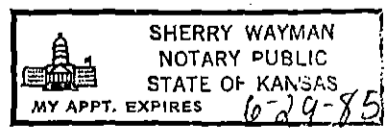

Sherry Wayman
SHERRY WAYMAN (NOTARY PUBLIC)

MY COMMISSION EXPIRES: _____

** The person who can be reached by phone regarding any questions concerning this information.

RECEIVED
STATE CORPORATION COMMISSION
AUG 04 1982
CONSERVATION DIVISION
Wichita, Kansas

SIDE TWO

ACO-1 WELL HISTORY

OPERATOR Assoc. Petro. Consultants LEASE Steffen #2

SEC. 12 TWP. 29S RGE. 10W

FILL IN WELL LOG AS REQUIRED:

FORMATION DESCRIPTION, CONTENTS, ETC.		TOP	BOTTOM	NAME	DEPTH
DST #1 2502 - 2527 op25 si60 op15 si30 Packer failed - test invalid.				Indian Cave	2504 (-750)
				Wabaunsee	2549 (-795)
				RTD	2600 (-846)
				LTD	2601 (-847)
DST #2 2474 - 2537 op30 si60 op30 si60 Opened tool with a weak blow building to fair, then decreasing to very poor. Second opening had no blow. Recovered: 35' of drilling mud.					
IHH	1269	FHH	1237		
ICIP	86-86	FCIP	97-97		
IFP	129	FFP	129		
BHT	101°				

Report of all strings set— surface, intermediate, production, etc. CASING RECORD (New) or (Used)

Purpose of string	Size hole drilled	Size casing set (in O.D.)	Weight lbs/ft.	Setting depth	Type cement	Sacks	Type and percent additives
Surface	12 1/4"	8 5/8"	23#	326'	Common	300	3% CaCl 2% gel

LINER RECORD

PERFORATION RECORD

Top, ft.	Bottom, ft.	Sacks cement	Shots per ft.	Size & type	Depth interval
N/A			N/A		

TUBING RECORD

Size	Setting depth	Packer set at
N/A		

ACID, FRACTURE, SHOT, CEMENT SQUEEZE RECORD

Amount and kind of material used	Depth interval treated
N/A	

Date of first production	Producing method (flowing, pumping, gas lift, etc.)	Gravity
N/A		

RATE OF PRODUCTION PER 24 HOURS	Oil	Gas	Water	Gas-oil ratio
	bbls.	bbls.	MCF	bbls.

Disposition of gas (vented, used on lease or sold)	Perforations
N/A	