


Give All Information Completely
Make Required Affidavit
Mail or Deliver Report to:
Conservation Division
State Corporation Commission
211 No. Broadway
Wichita, Kansas

WELL PLUGGING RECORD

NORTH

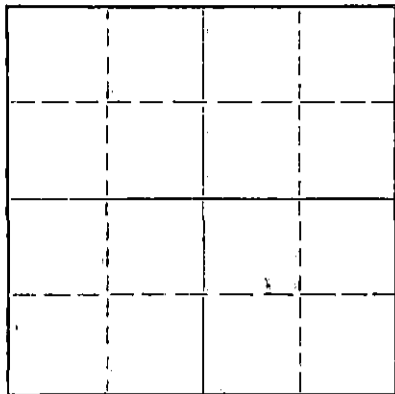

Locate well correctly on above
Section Plat

Ford County, Sec. 12 Twp. 29S Rge. 26W (E) (W)
Location as "NE/CNW/SW" or footage from lines SE NE
Lease Owner Thunderbird Drilling, Inc.
Lease Name Rost Well No. 1
Office Address P.O. Box 18407-Wichita, Ks. 67218
Character of Well (completed as Oil, Gas or Dry Hole) Dry Hole
Date well completed 4/29/80 19
Application for plugging filed 4/29/80 19
Application for plugging approved 4/29/80 19
Plugging commenced 4/29/80 19
Plugging completed 4/29/80 19
Reason for abandonment of well or producing formation Dry Hole

If a producing well is abandoned, date of last production 19
Was permission obtained from the Conservation Division or its agents before plugging was commenced? Yes

Name of Conservation Agent who supervised plugging of this well Mr. Clarence Thomas
Producing formation Depth to top Bottom Total Depth of Well 5350 Feet
Show depth and thickness of all water, oil and gas formations.

OIL, GAS OR WATER RECORDS

CASING RECORD

FORMATION	CONTENT	FROM	TO	SIZE	PUT IN	PULLED OUT
	Surface			8 5/8"	492'	None

Describe in detail the manner in which the well was plugged, indicating where the mud fluid was placed and the method or methods used in introducing it into the hole. If cement or other plugs were used, state the character of same and depth placed, from feet to feet for each plug set.

1st plug @ 498' w/50 sx
2nd plug @ 40' w/10 sx
5 sx in rat hole

RECEIVED
STATE CORPORATION COMMISSION

MAY 19 1980

CONSERVATION DIVISION
Wichita, Kansas

5-19-1980

(If additional description is necessary, use BACK of this sheet)
Name of Plugging Contractor Thunderbird Drilling, Inc.
Address P.O. Box 18407- Wichita, Ks. 67218

STATE OF KANSAS, COUNTY OF SEDGWICK, ss.
Burke Krueger (employee of owner) or (owner or operator) of the above-described well, being first duly sworn on oath, says: That I have knowledge of the facts, statements, and matters herein contained and the log of the above-described well as filed and that the same are true and correct. So help me God.


(Signature) *Burke Krueger*

P.O. Box 18407- Wichita, Ks. 67218
(Address)

SUBSCRIBED AND SWORN TO before me this 16th day of May, 19 80

My commission expires 3-25-84

Gloria DeJesus
Gloria DeJesus Notary Public.

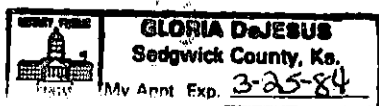

DRILLERS LOG

Company Thunderbird Drilling, Inc.

Contractor Thunderbird Drilling, Inc

Elevation 2590' K.B.

Farm Rost

Well No. 1

Casing 8 5/8" @ 492' w/350 sx

Location SE NE
Sec. 12-29S-26W
County Ford County, Ks.

Production

<u>From</u>	<u>To</u>	<u>Description</u>
0	160	Surface hole
160	830	Shale
830	1015	Shale & Shells
1015	1035	Anhydrite
1035	1350	Shale
1350	1845	Shale & Shells
1845	2062	Shale & Shells & Sand
2062	2246	Shale & Lime streaks
2246	2498	Shale & Lime
2498	4040	Lime & Shale
4040	4195	Shale & Lime
4195	4735	Lime & Shale
4735	4880	Lime
4880	4940	Lime & Shale
4940	5350	Lime
5350	R.T.D.	

STATE OF KANSAS)
) ss.
COUNTY OF SEDGWICK)

RECEIVED
MAY 19 1980

I, Burke Krueger, of Thunderbird Drilling, Inc. upon oath states that the above and foregoing is a true and correct copy from the Daily Drilling Report from your Rost #1.

Burke Krueger

Subscribed and sworn to before me this 16th day of May, 1980

Gloria DeJesus
Gloria DeJesus Notary Public

My commission expires: 3-25-84

