

STATE OF KANSAS
STATE CORPORATION COMMISSION

WELL PLUGGING RECORD

OR
FORMATION PLUGGING RECORD


Strike out upper line when reporting plugging off formations.

Give All Information Completely
Make Required Affidavit
Mail or Deliver Report to:
Conservation Division
State Corporation Commission
800 Bitting Building
Wichita, Kansas

Ford County. Sec. 17 Twp. 29S Rge. 26W(E) (W)

Location as "NE 1/4 NW 1/4 SW 1/4" or footage from lines. SW SW SW
Lease Owner. The Texas Company
Lease Name. L. M. Weatherbee Well No. 1
Office Address. Box 2420, Tulsa, Oklahoma
Character of Well (completed as Oil, Gas or Dry Hole) Dry
Date well completed. November 27, 19 44
Application for plugging filed. December 3, 19 44
Application for plugging approved. December 4, 19 44
Plugging commenced. December 4, 19 44
Plugging completed. December 4, 19 44
Reason for abandonment of well or producing formation Dry

NORTH

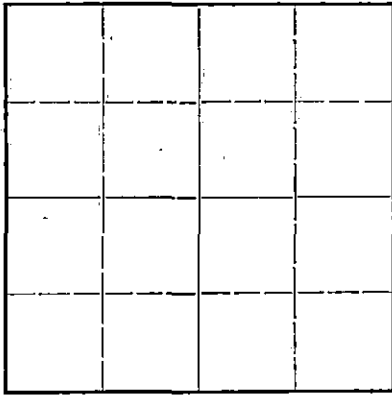

Locate well correctly on above Section Flat

If a producing well is abandoned, date of last production. 19...
Was permission obtained from the Conservation Division or its agents before plugging was commenced? Yes

Name of Conservation Agent who supervised plugging of this well. Ruel E. Durkee, McPherson, Kansas
Producing formation. Depth to top. Bottom. Total Depth of Well. 6493 Feet
Show depth and thickness of all water, oil and gas formations.



OIL, GAS OR WATER RECORDS

CASING RECORD

Formation	Content	From	To	Size	Put In	Pulled Out
				13-3/8"	200'	
				8-5/8"	1450'	

Describe in detail the manner in which the well was plugged, indicating where the mud fluid was placed and the method or methods used in introducing it into the hole. If cement or other plugs were used, state the character of same and depth placed, from... feet to... feet for each plug set.

Heavy Mud from 6492' to 350'
20 sax cement 350' to 325'
Heavy Mud from 325' to 37'
10 Sax cement 37' to 0'

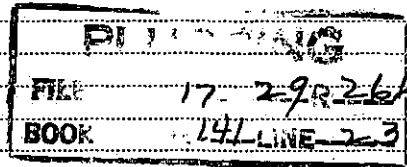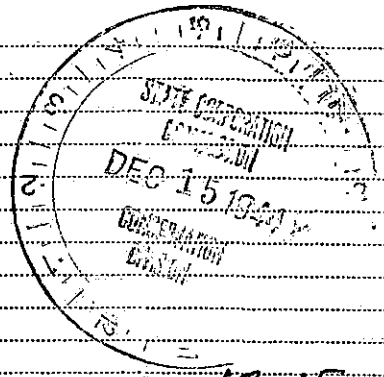

12-15-1944

(If additional description is necessary, use BACK of this sheet)

Correspondence regarding this well should be addressed to The Texas Co., Prod. Dept.
Address Box 1801, Wichita, Kansas

STATE OF Kansas, COUNTY OF Sedgwick, ss.
M. C. Harrell (employee of owner) or (owner) of the above-described well,

being first duly sworn on oath, says: That I have knowledge of the facts, statements, and matters herein contained and the log of the above-described well as filed and that the same are true and correct. So help me God.

(Signature) M. C. Harrell

Box 1801, Wichita, Kansas
(Address)

SUBSCRIBED AND SWORN to before me this 15th day of December, 19 44.

My commission expires Aug 26, 1945. Notary Public.

LOG OF WELL

SHEET _____

OWNER The Texas Company DIVISION Oklahoma-Kansas DATE MADE December 15, 1944
 DISTRICT Kansas LEASE L. M. Weatherbee WELL NO. 1
 STATE Kansas COUNTY OR PARISH Ford TWP. 29S RANGE 26W SEC. 17
 LOCATION OF WELL SW SW SW

COMMENCED RIGGING UP 9/28/44 COMMENCED DRILLING 9/28/44 COMPLETED DRILLING 11/27/44
 DAY DRILLER _____ NIGHT DRILLER _____ CONTRACTOR Herndon Drly Co.
 CABLE FROM _____ TO _____ ROTARY FROM 0 TO 6493 COMPANY RIG No. _____
 TOTAL DEPTH 6493 MEASURED BY _____ ELEVATION 2593

CASING RECORD

SIZE	WEIGHT	PUT IN WELL		PULLED OUT		LOST IN WELL		SHOES		PACKERS		
		FEET	INS.	FEET	INS.	FEET	INS.	LENGTH	MAKE	KIND	LENGTH	SET AT
13-3/8"	48# SS	200				W/ 250	sax cement					FT.
8-5/8"	32#	1450'				W/ 800	sax cement & 300 sax outside					FT.
												FT.
												FT.
												FT.
												FT.
												FT.
												FT.

WAS CASING CEMENTED? _____ IF SO, HOW MANY SACKS OF CEMENT USED? _____
 LINER: STATE SIZE AND WEIGHT _____ WHERE SET _____ FT. AND INS. BLANK _____ FT. AND INS. PERFORATED _____
 HOW PUT TOGETHER _____ COUPLING _____ FLUSH-JOINT _____ INSERTED _____
 REMARKS: _____

EQUIPMENT RECORD

TUBING				SUCKER RODS			PUMPING OUTFIT
SIZE	WEIGHT	FEET	INS.	FEET	INS.	SIZE AND KIND	DESCRIPTION, KIND, SIZE, ETC.

FLOWING, PUMPING, GASSER OR DRY Dry PRODUCTION FIRST 24 HOURS _____ PRODUCTION SETTLED _____
 IF GAS WELL, OPEN FLOW CAPACITY _____ SHUT IN PRESSURE _____ ROCK PRESSURE _____
 KIND OF SHOT _____ SIZE OF SHOT, QUARTS _____
 NUMBER OF SHELLS _____ SIZE OF SHELLS _____ INCHES, DIAMETER _____
 LENGTH OF SHELLS _____ FEET _____ INCHES _____ TOP OF SHOT _____
 BOTTOM OF SHOT _____ ANCHOR _____ WELL BRIDGED TO _____
 TOTAL DEPTH OF WELL _____ NUMBER OF SHOT _____ PRODUCTION BEFORE SHOT _____ BBLs. PER DAY _____
 PRODUCTION AFTER SHOT _____ BBLs. PER DAY. SHOT FURNISHED BY _____
 NAME OF SHOOTER _____ SHOT INSPECTED _____ BY _____ (COMPANY EMPLOYEE)
 COMMENCED DRILLING DEEPER _____ COMPLETED _____ DRILLING DEEPER _____
 TOTAL DEPTH _____ PRODUCTION FIRST 24 HOURS _____ PRODUCTION SETTLED _____
 REMARKS: Tops: Anh 1450', Lansing 4245', Miss 5120', Viola 6070', Simp. 6328', Arb. 6380'.

NOTE: IF WELL WAS DRY, STATE UNDER REMARKS, WHEN, HOW, AND BY WHOM PLUGGED.
 STATE UNDER REMARKS ANYTHING OF INTEREST NOT COVERED IN LOG.
 IF THE SPACE PROVIDED FOR REMARKS IS NOT SUFFICIENT WRITE ON BOTTOM OF LAST SHEET OF LOG.

LOG OF WELL

SHEET No. _____

District **Kansas**

Owner **The Texas Co.**

Farm **L.M. Weatherbee**

Well No. **1**

FORMATION	AMOUNT	COLOR	HARD OR SOFT	DEPTH CORES TAKEN	REMARKS
Surface	200				
Shale & Shells	500				
Sand & Shale	660				
Shale	720				
Red Bed	815				
Red Bed & Shale	960				
Lime	1035				
Red Bed	1070				
Red Bed & Gyp	1350				
Red Bed	1450				
Anhydrite	1490				
Sand	1680				
Shale & Shells	1890				
Shale & Shells	2540				
Lime	2630				
Sand & Lime	2675				
Sandy Lime	2755				
Lime	3130				
Lime & Chert	3210				
Lime	3940				
Lime & Chert	4110				
Lime	4480				
Lime & Chert	4500				
Lime	4820				
Lime & Chert	4850				
Lime	4930				
Lime & Chert	4965				
Lime	5340				
Lime & Chert	5350				
Chert & Lime	5365				
Lime & Chert	5385				
Chert & Lime	5460				
Lime & Chert	5800				
Lime	5820				
Lime & Chert	5835				
Lime	5870				
Lime & Chert	6000				
Lime, Sandy, & Chert	6010				
Lime & Chert	6030				
Sandy Lime & Chert	6075				
Lime & Chert	6185				
Shale	6205				
Lime & Chert	6275				
Chert	6295				
Lime & Chert	6330				
Sand	6365				
Sand & Shale	6385				
Shale & Sand	6430				
Lime	6493				

T.D.

PLUGGING
 FILE 7-29-26W
 BOOK PAGE 141 LINE 23